

THIS MAP IS NOT INTENDED TO PROVIDE LEGAL DIMENSIONS OR LOCATIONS OF PROPERTY OWNERSHIP LINES.

SENE

Fern Ridge Reservoir

SWNW

SENW

Northern Boundary J.C.
Inman D.L.C. 43

Tax Lot
200

11.91 Acres

3.40 Acres

15.67 Acres

Sec 7

Sec 8

15.01 Acres

Center of
Section 8

NESE

NWSW

NESW

Fern Ridge Reservoir

RECEIVED

North Field Flow Meter
17-08130-08 and shutoff valve

OCT 01 2018

Tax Lot 100

8-Inch Handline
Distribution Pipe

OWRD

Point of diversion, fish screen,
pump, and meter 17-05283-08
748 ft W & 2035 ft S
of the center of Section 8

SWSW

SESW

Southern Boundary J.C.
Inman D.L.C. 43

Application S88247, Permit S55018
Township 17 S Range 5 W Section 8
Lane County Tax Lot 17-05-08-00-00100



1 inch = 400 feet

Township	Range	Section	Qtr-Qtr	Qtr	DLC	Acres
17	5	8	SW	NW	43	3.40
17	5	8	SE	NW	43	11.91
17	5	8	NW	SW	43	15.67
17	5	8	NE	SW	43	15.01
Total						45.99



Area Irrigated
under permit
S55018

Quarter
Quarter
Lines

Reservoir
Boundary

Tax Lot
Boundaries

DLC Lines

Section
Lines

Quarter
Section Lines

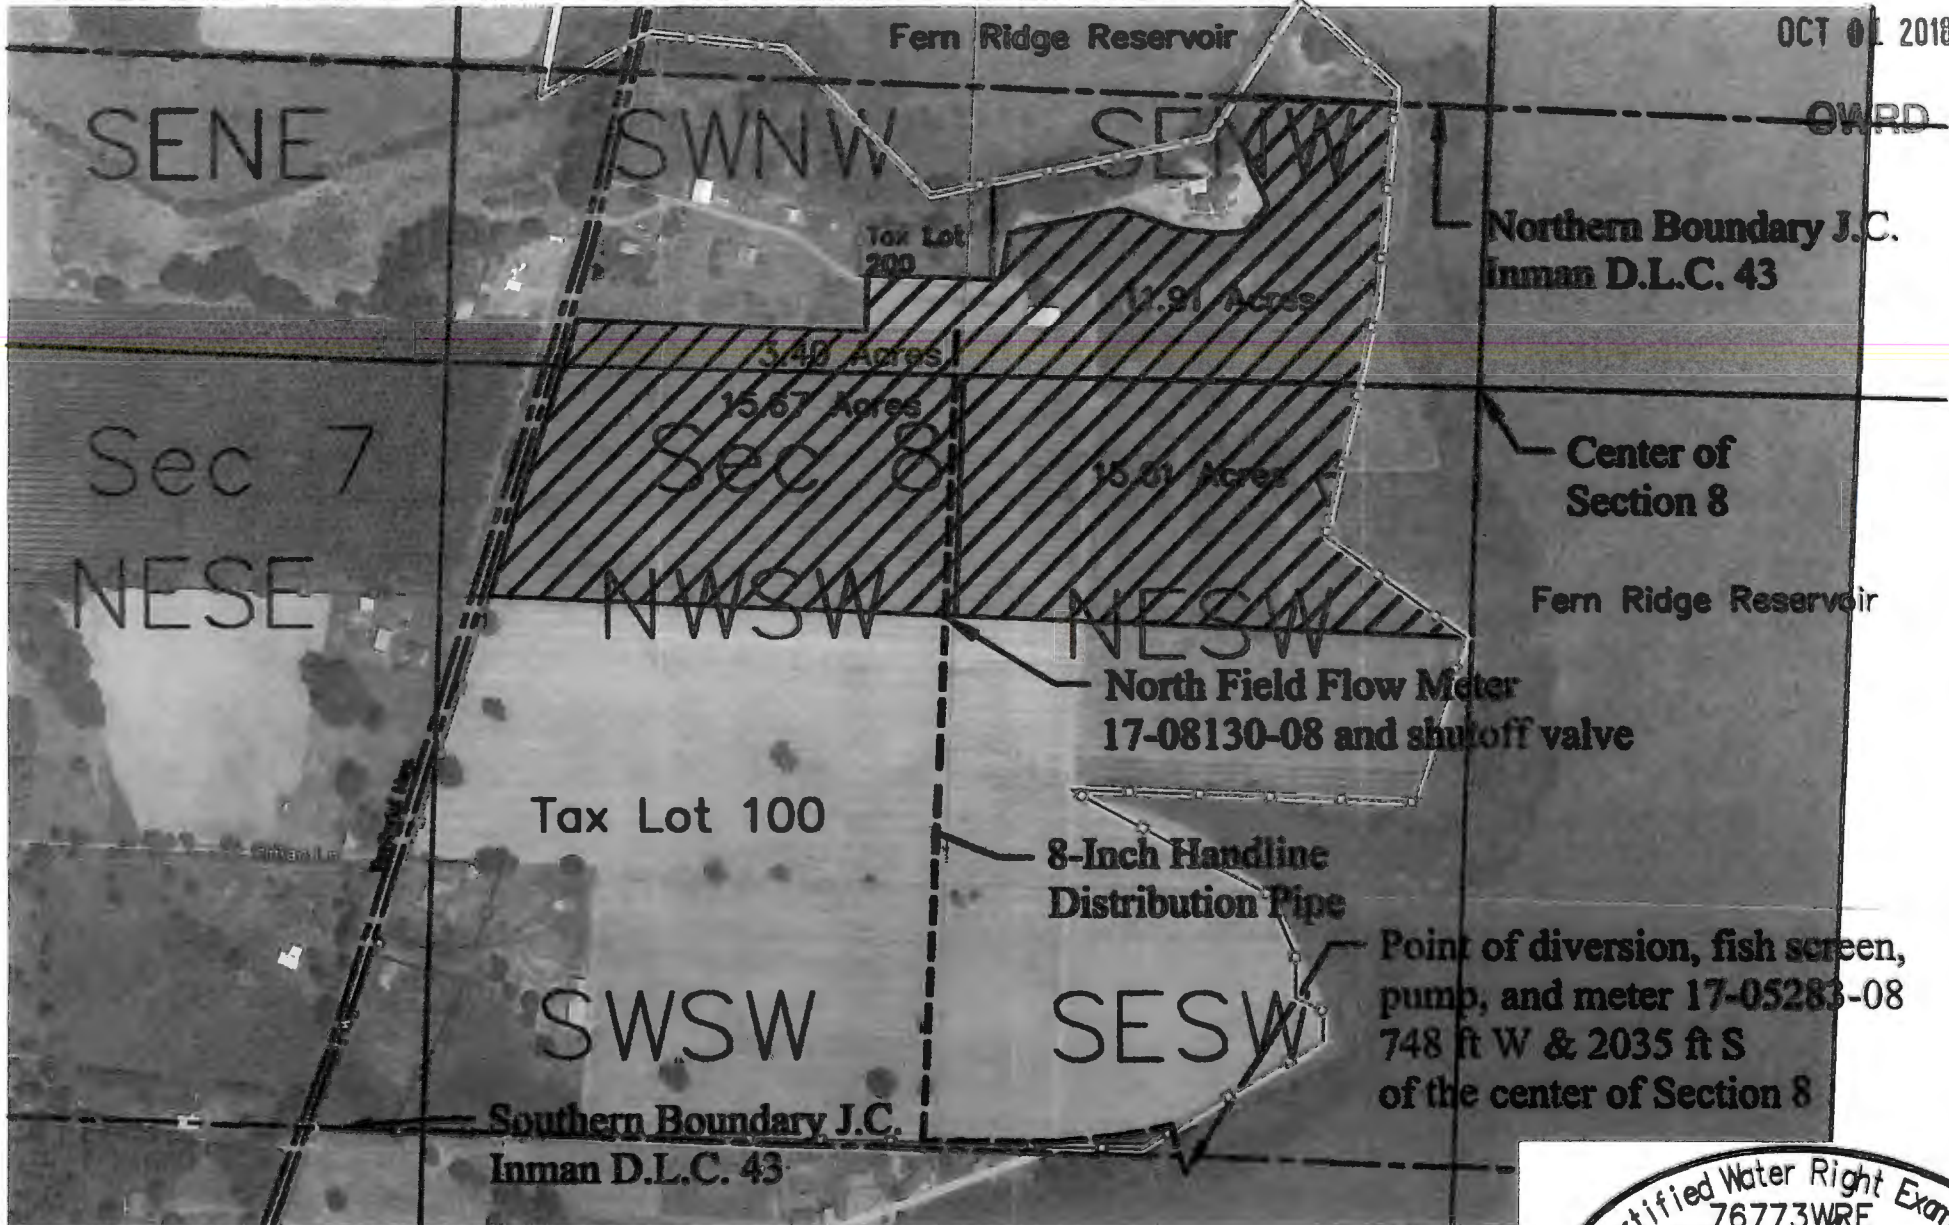


EXPIRATION DATE: 12/31/18

THIS MAP IS NOT INTENDED TO PROVIDE LEGAL DIMENSIONS OR LOCATIONS OF PROPERTY OWNERSHIP LINES.

RECEIVED


OCT 01 2018



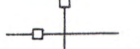
Application S88247, Permit S55018
 Township 17 S Range 5 W Section 8
 Lane County Tax Lot 17-05-08-00-00100

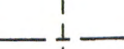
Township	Range	Section	Qtr-Qtr	Qtr	DLC	Acres
17	5	8	SW	NW	43	3.40
17	5	8	SE	NW	43	11.91
17	5	8	NW	SW	43	15.67
17	5	8	NE	SW	43	15.01
Total						45.99


 Area irrigated under permit S55018



 Quarter Quarter Lines


 Reservoir Boundary


 Tax Lot Boundaries

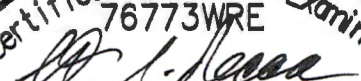

 DLC Lines


 Section Lines


 Quarter Section Lines



1 inch = 400 feet

Certified Water Right Examiner
 76773WRE

 Steven I Recca
 June 29, 2007
 STATE OF OREGON

EXPIRATION DATE: 12/31/18