



T.4S. R.1E. Section 10

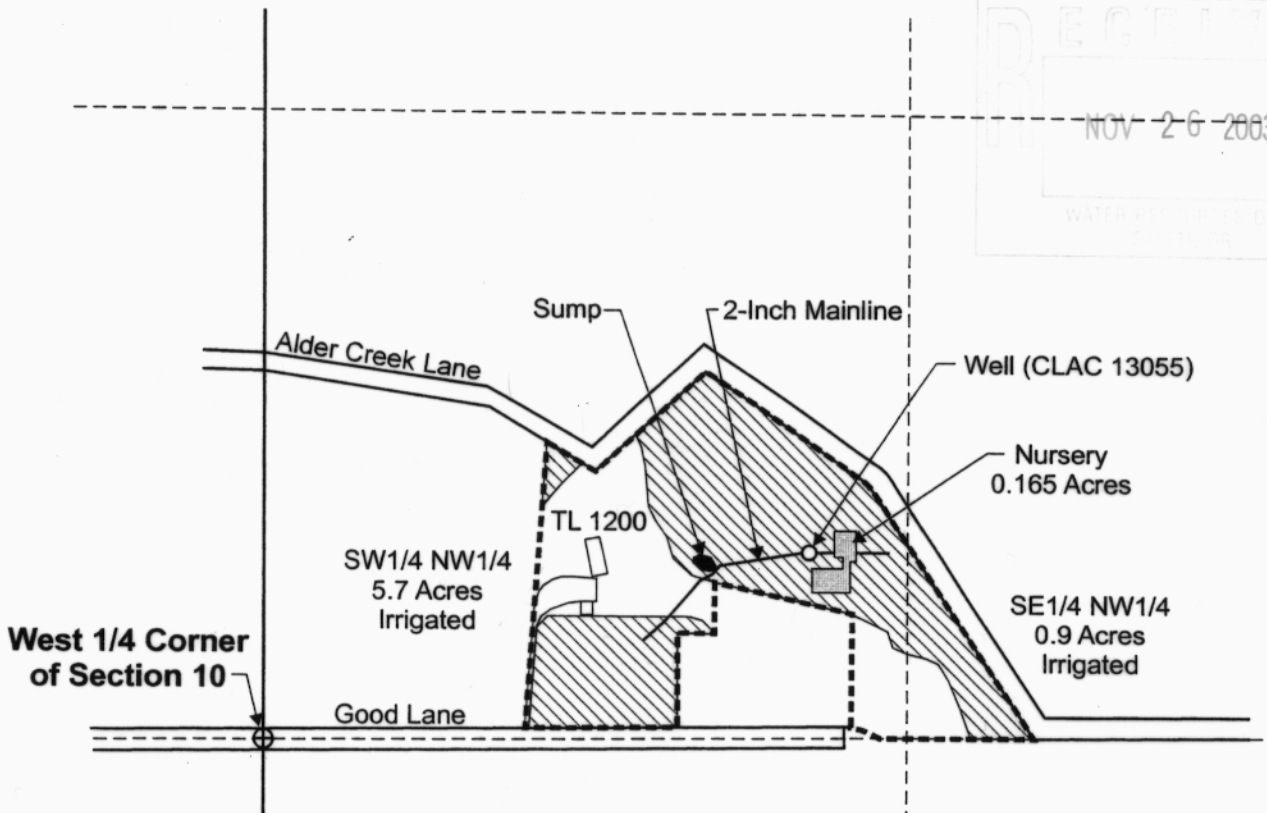


Well (CLAC 13055) is located 395 feet north and 1,140 feet east from the W 1/4 corner of Section 10
 Sump is located 370 feet north and 920 feet east from the W 1/4 corner of Section 10

- Area (6.6 Acres) irrigated under Application G-12740, Permit G-11828.
- Area (0.165 Acres) for nursery use under Application G-12740, Permit G-11828.
- Tax Lot Boundary

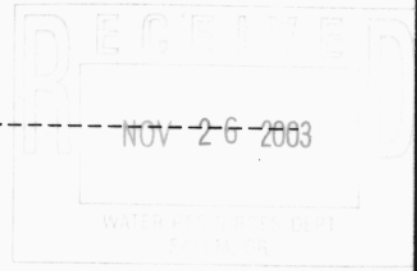

EXPIRATION DATE 6/30/05

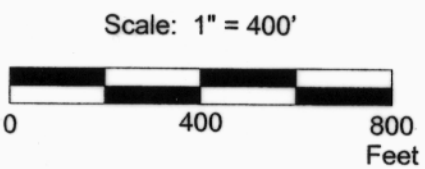

This map was prepared for the purpose of identifying the location of a water right only and is not intended to provide legal dimensions or location of property ownership lines.



Claim of Beneficial Use Map

Brian Heintz
 T.4S. R.1E. Sec. 10, Tax Lot 1200

Pacific Hydro-Geology Inc.