


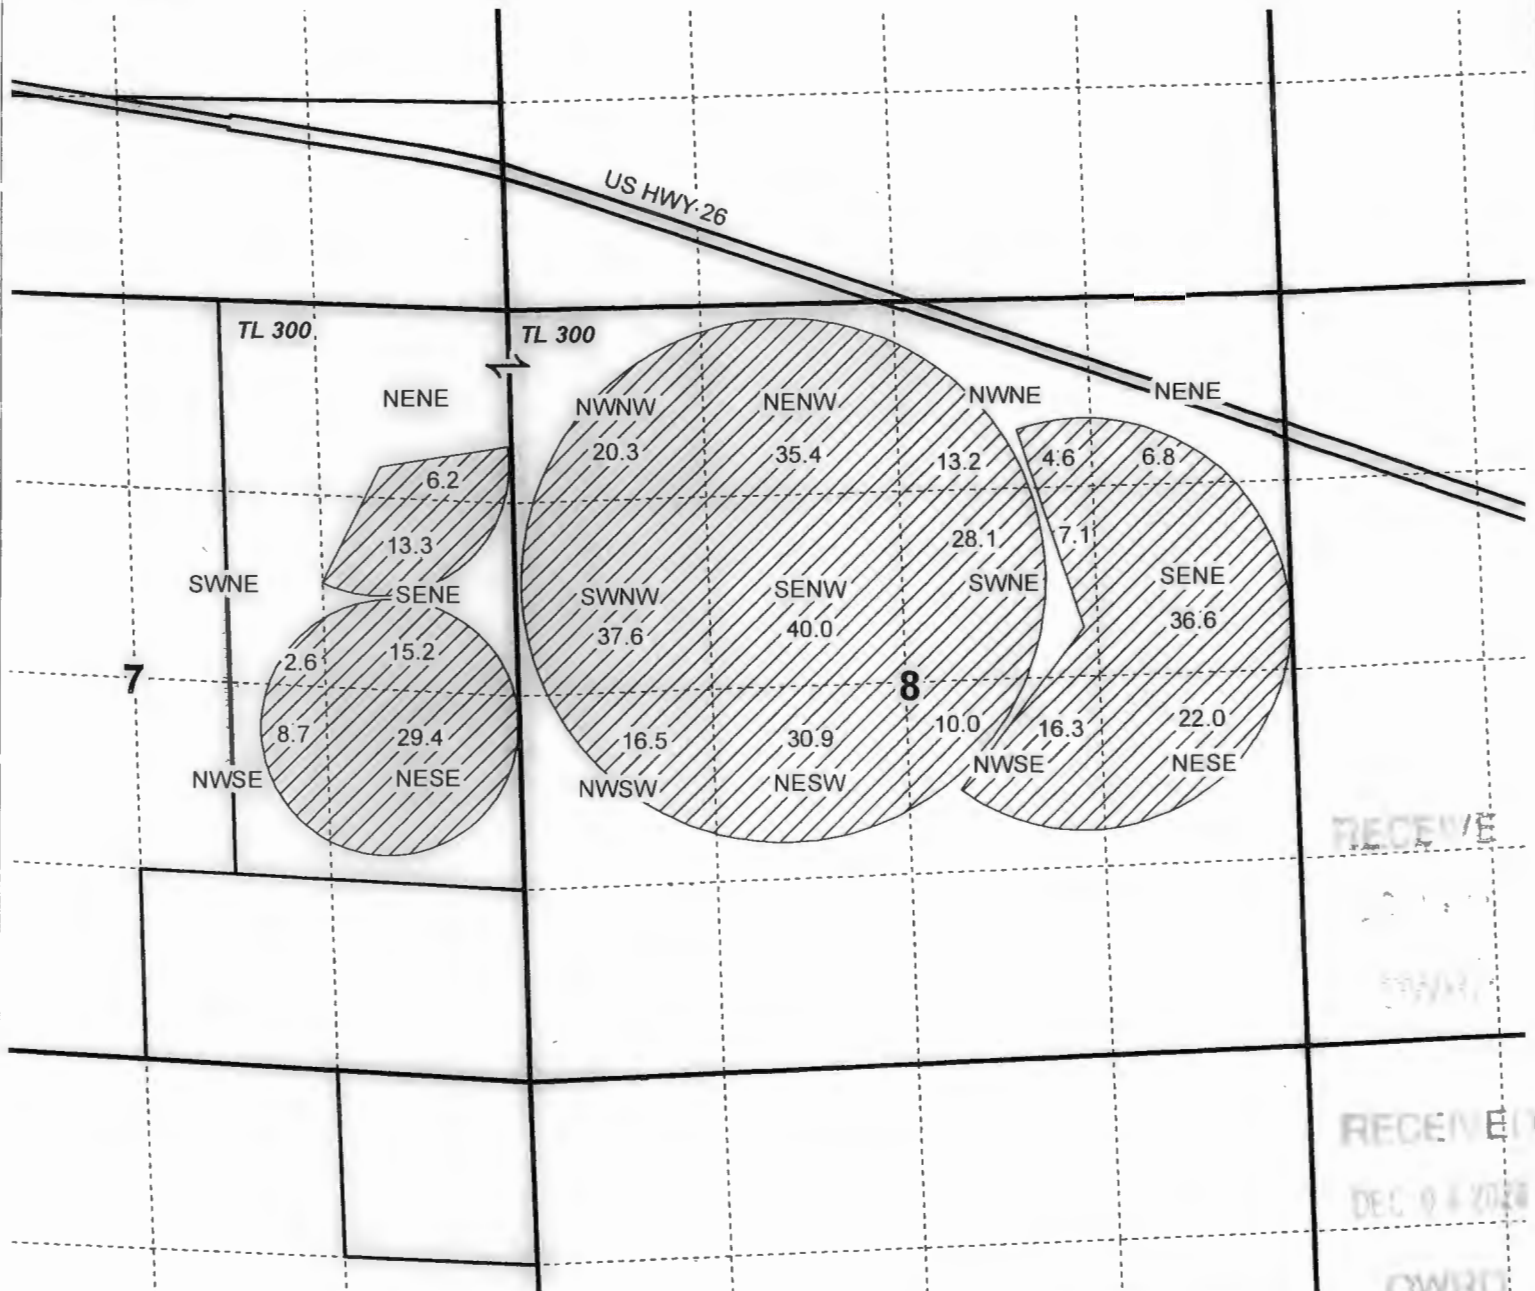

0 1,320 Feet

1" = 1,320'

# T15S R41E, WM MALHEUR COUNTY, OREGON




POU IR. (5-10-1951 from C-81210)

Section

Quarter Quarter

Tax Lot

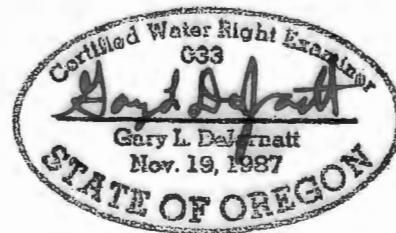

RENEWAL DATE 12/31/2019



## CLAIM OF BENEFICIAL USE MAP COW VALLEY RANCH

This map is not intended to provide legal dimensions or locations of property ownership lines.

## WATER RIGHT SERVICES, LLC

PO BOX 1830, BEND, OR 97709

CCB# 197121 [www.oregonwater.us](http://www.oregonwater.us)

541-389-2837 [JOHNSHORT@USA.COM](mailto:JOHNSHORT@USA.COM)

T-12072

Project #19046

Date: 12/26/2019

RECEIVED  
DEC 9 4 2019  
OWRD




0 1,320 Feet

1" = 1,320'


# T15S R41E, WM

MALHEUR COUNTY, OREGON

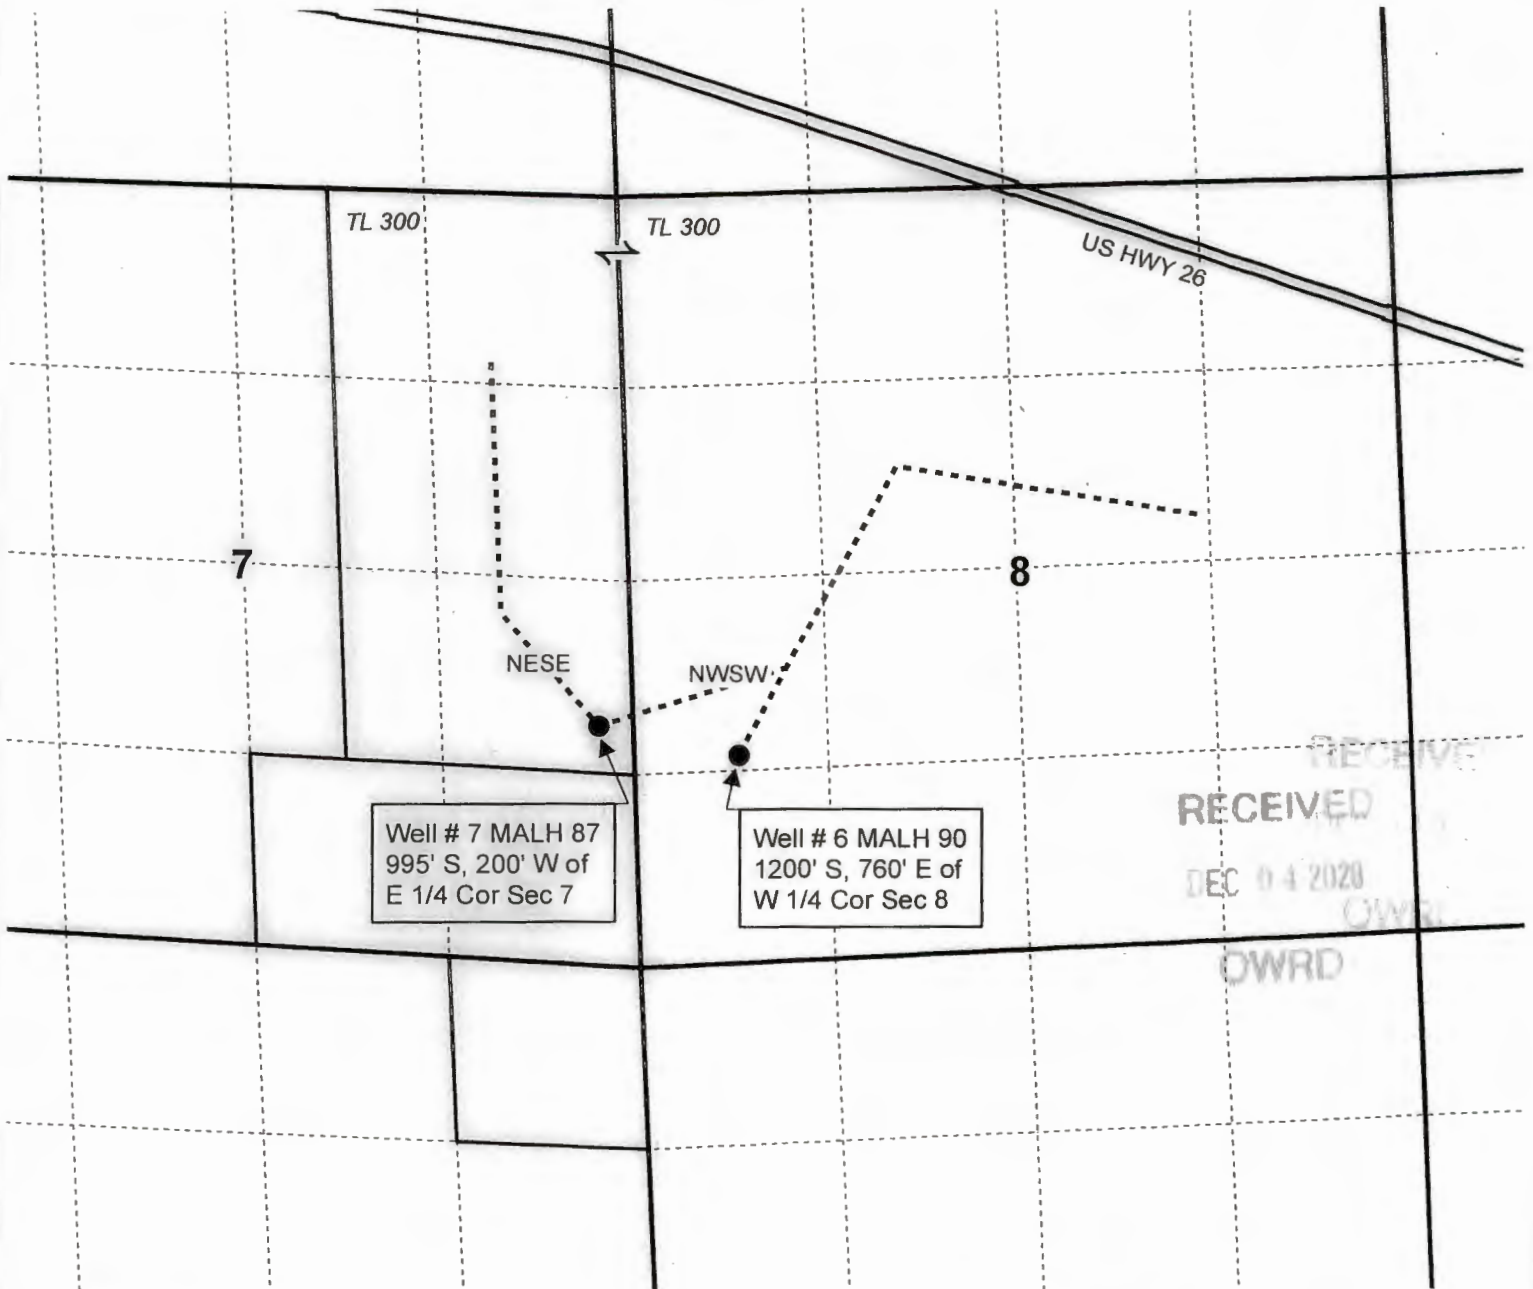

RECEIVED  
DEC 04 2020  
DWRD

- Well & Meter
- Pipeline
- Section
- - - - Quarter Quarter
- Tax Lot

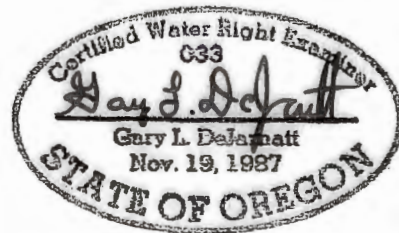

RENEWAL DATE 12/31/2019



## CLAIM OF BENEFICIAL USE MAP COW VALLEY RANCH

This map is not intended to provide legal dimensions or locations of property ownership lines.

## WATER RIGHT SERVICES, LLC

PO BOX 1830, BEND, OR 97709

CCB# 197121 [www.oregonwater.us](http://www.oregonwater.us)

541-389-2837 [JOHNSHORT@USA.COM](mailto:JOHNSHORT@USA.COM)

T-12072

Project #19046

Date: 12/26/2019