


CLAIM OF BENEFICIAL USE MAP

TO ADD POINTS OF APPROPRIATION
FOR T-12108
STEVE C. SCOTT

SECTIONS 23, 24, & 25, TOWNSHIP 29 SOUTH, RANGE 17 EAST, W.M.
TAX LOT: 700

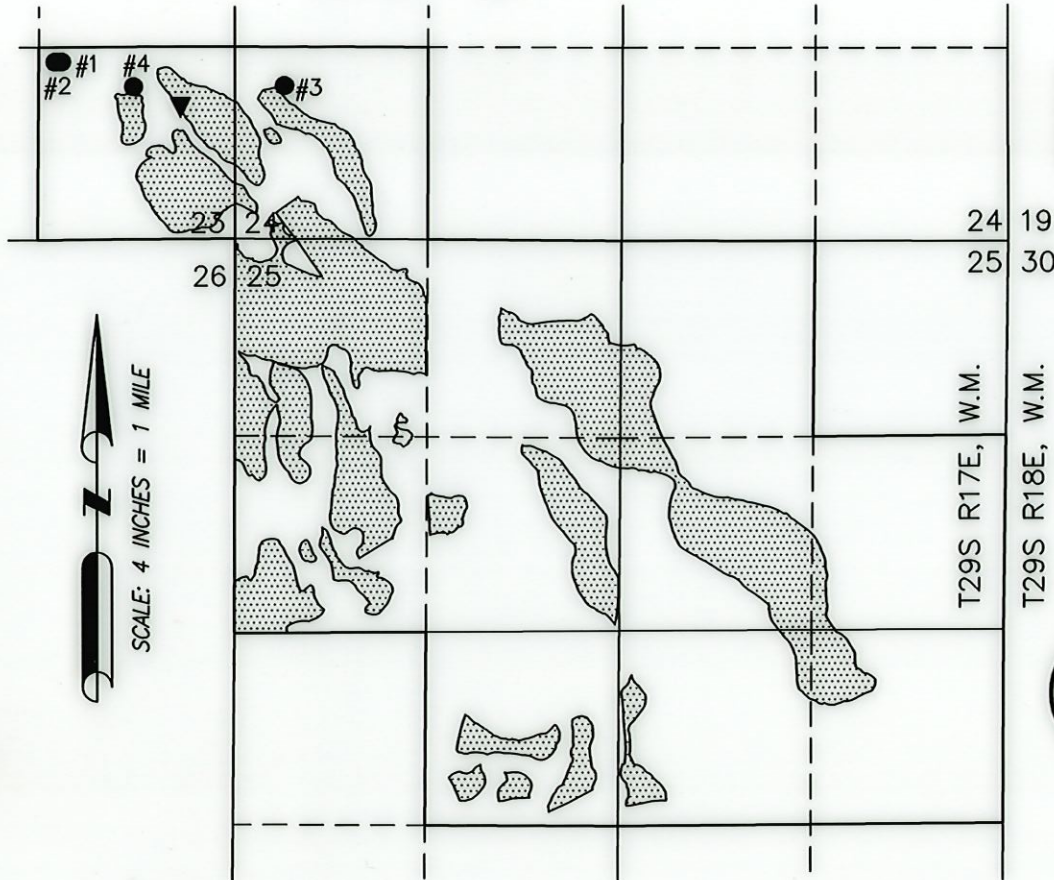

THIS MAP IS FOR THE PURPOSE OF
LOCATING A WATER RIGHT ONLY AND HAS
NO INTENT TO PROVIDE LEGAL DIMENSIONS
OR THE LOCATION OF PROPERTY LINES


RECEIVED

APR 19 2021

OWRD



PLACE OF USE PER CERTIFICATE
#75981 (G-10580), AS SHOWN.

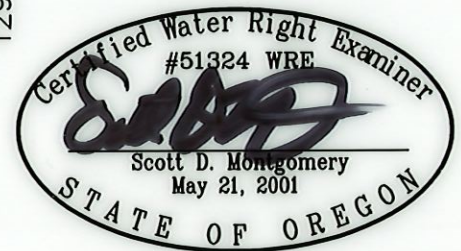

RENEWAL DATE: 12/31/2022

● #1 LAKE 1447

AUTHORIZED WELL IN THE SE 1/4 SE 1/4 SECTION
23, LOCATED 1220 FEET NORTH AND 1190 FEET
WEST FROM THE SE CORNER OF SECTION 23.

FLOW METER IS APPROXIMATELY 25 FEET EAST ALONG
DELIVERY PIPE FROM WELL.

● #2 LAKE 3028

AUTHORIZED WELL IN THE SE 1/4 SE 1/4 SECTION 23.
LOCATED 1220 FEET NORTH AND 1230 FEET WEST FROM
THE SE CORNER OF SECTION 23.

FLOW METER IS APPROXIMATELY 5.0 FEET EAST ALONG
DELIVERY PIPE FROM CENTER PIVOT.

● #3 LAKE 4021

AUTHORIZED WELL IN THE SW 1/4 SW 1/4 SECTION
24, LOCATED 1050 FEET NORTH AND 340 FEET EAST
FROM THE SW CORNER OF SECTION 24.

FLOW METER IS APPROXIMATELY 54 FEET SW'LY ALONG
DELIVERY PIPE FROM WELL.

● #4 LAKE 52819

TRANSFER WELL IN THE SE 1/4 SE 1/4 SECTION 23.
LOCATED 1045 FEET NORTH AND 695 FEET WEST FROM THE
SE CORNER OF SECTION 23.

▼ FLOW METER IS LOCATED AT 43°02'15" N 120°39'53" W
PER WGS84 PROJECTION

PREPARED FOR:

STEVE C. SCOTT
62526 ERICKSON ROAD
BEND, OR 97701

PREPARED BY:



ALL POINTS ENGINEERING AND SURVEYING, INC.
P.O. BOX 767
(541) 548-5833
TERREBONNE, OR 97760
www.APEandS.com