


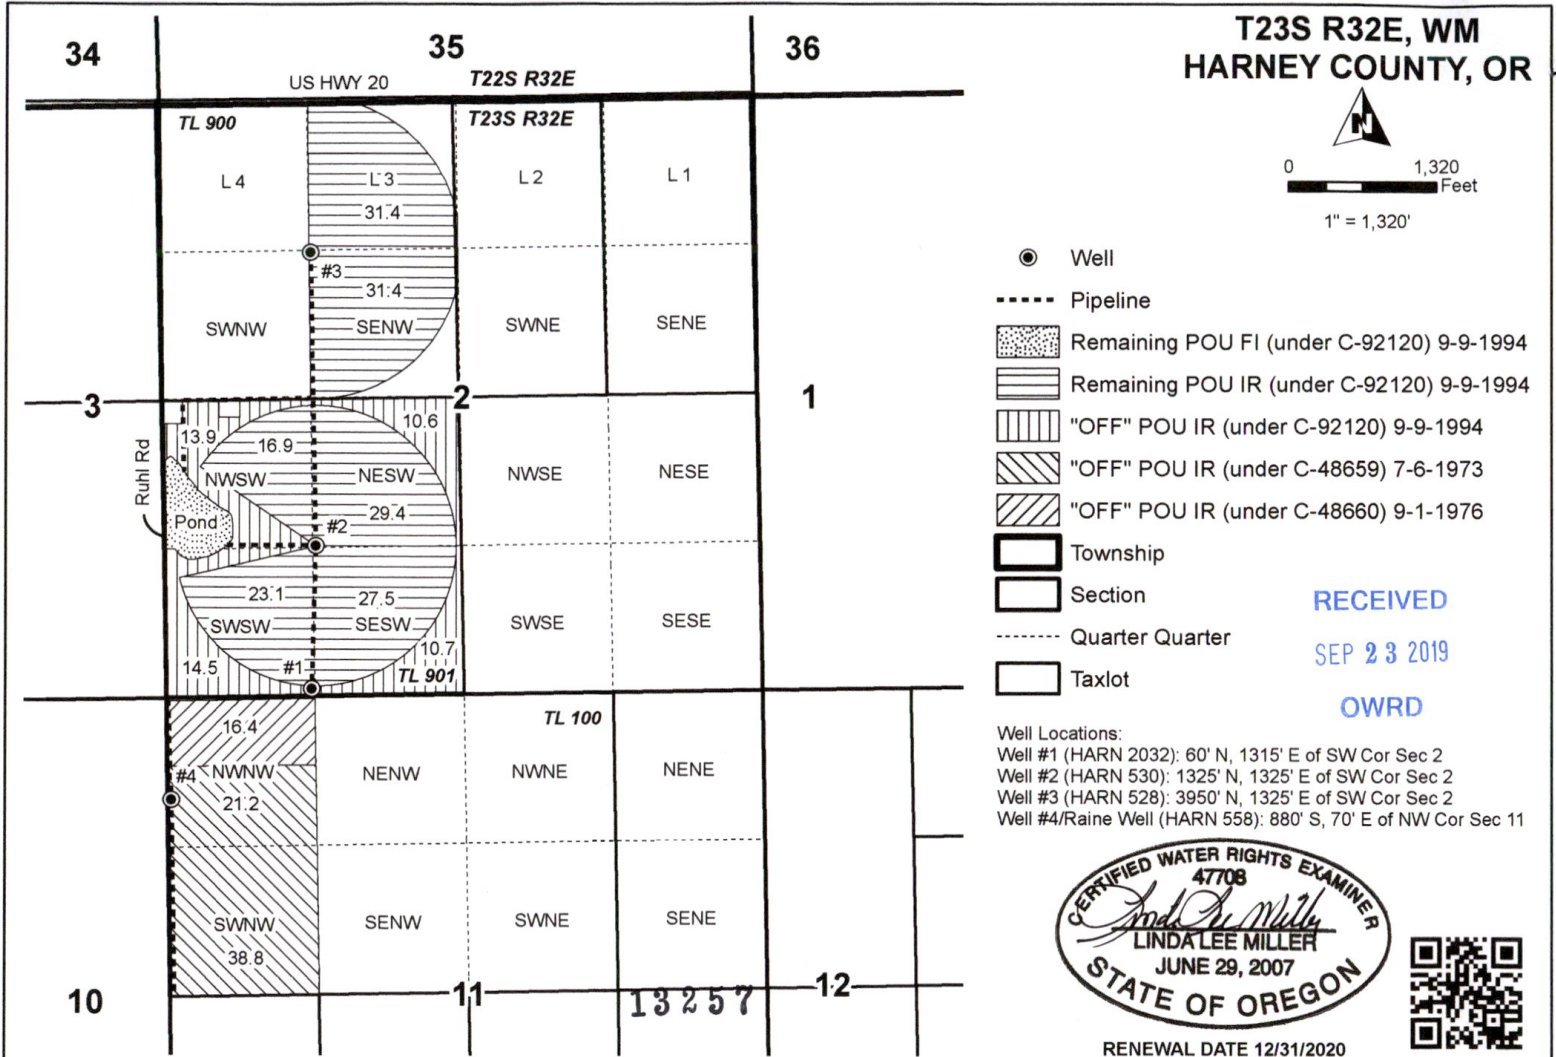

TRANSFER "OFF" MAP
Roger and Mindy Sheley

Transfer of Certificates 48659, 48660, & 92120

Date: 9/2/2019

This map is not intended
to provide legal dimensions
or locations of property
ownership lines.

WATER RIGHT SERVICES, LLC
PO BOX 1830, BEND, OR 97709
WWW.OREGONWATER.US CCB # 197121
johnshort@usa.com 541-389-2837



RENEWAL DATE 12/31/2020

WATER RIGHT SERVICES, LLC
PO BOX 1830, BEND, OR 97709
WWW.OREGONWATER.US CCB # 197121
johnshort@usa.com 541-389-2837