


**Claim of Beneficial Use  
Application S-88234  
Permit S-55042**

T36S R4W  
Sections 26, 27, 34

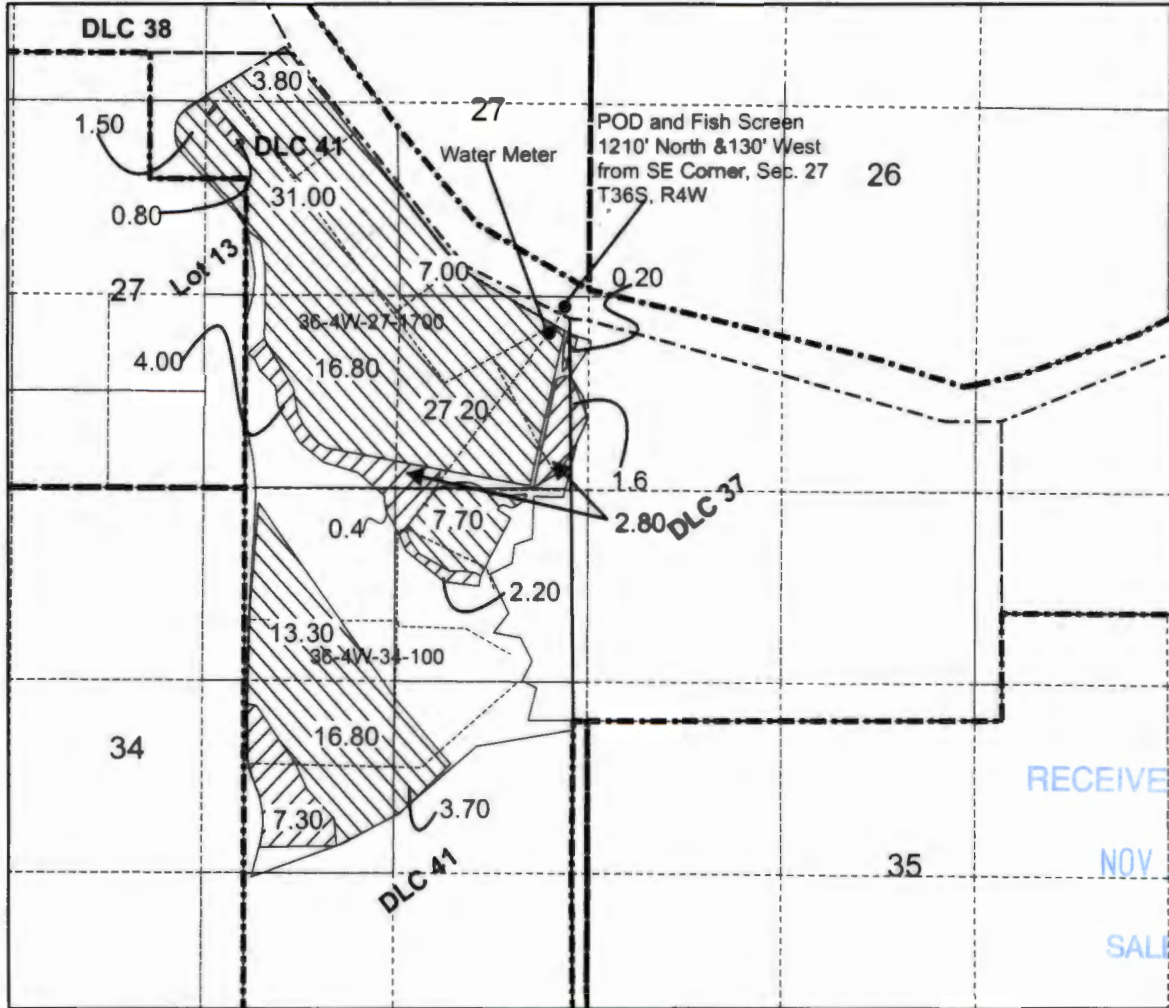


**Primary & Supplemental Water of Lost Creek Reservoir**

**Del Rio Vineyards, LLC**



Note: This map is not intended to provide legal dimensions or locations of property ownership lines.

**Legend**

-  S55042 Primary
-  S55042 Sup
-  Pipeline



1 inch = 1,320 feet

