

SCALE: 1"=1320'




Lands irrigated under G-16045

EXISTING WELL TIES

Latitude: 45°21'29.86867" N
Longitude 118°02'43.69719" W

N 1257.2' & W 52.4' from South 1/4 cor. Section 27.

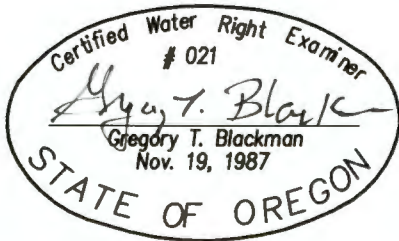

CLAIM OF BENEFICIAL USE MAP
AUTHORIZED UNDER G-16045
FOR
AUSTIN AND JEANA BINGAMAN ALSO
NW FARM CREDIT SERVICES FLCA

BY
GREG BLACKMAN WATER RIGHTS
126 RIDGE DRIVE
LA GRANDE, OREGON 97850
October 25, 2018

RECEIVED
AUG 27 2019
OWRD

APPLICATION NO. G-16481
PERMIT NUMBER G-16045

NOTE: The preparation of this map was for the purpose of identifying the location of the proposed water right and has no intent to provide dimensions or location of property ownership lines. Location information shown hereon was furnished by the applicant.