


# Grande Ronde Seed Farm

## Ap. G-16252/T-12607 Permit G-17985 Final Proof Survey Map

Township 3 South, Range 39 East (W.M.), Union County

COBU MAP # 1164

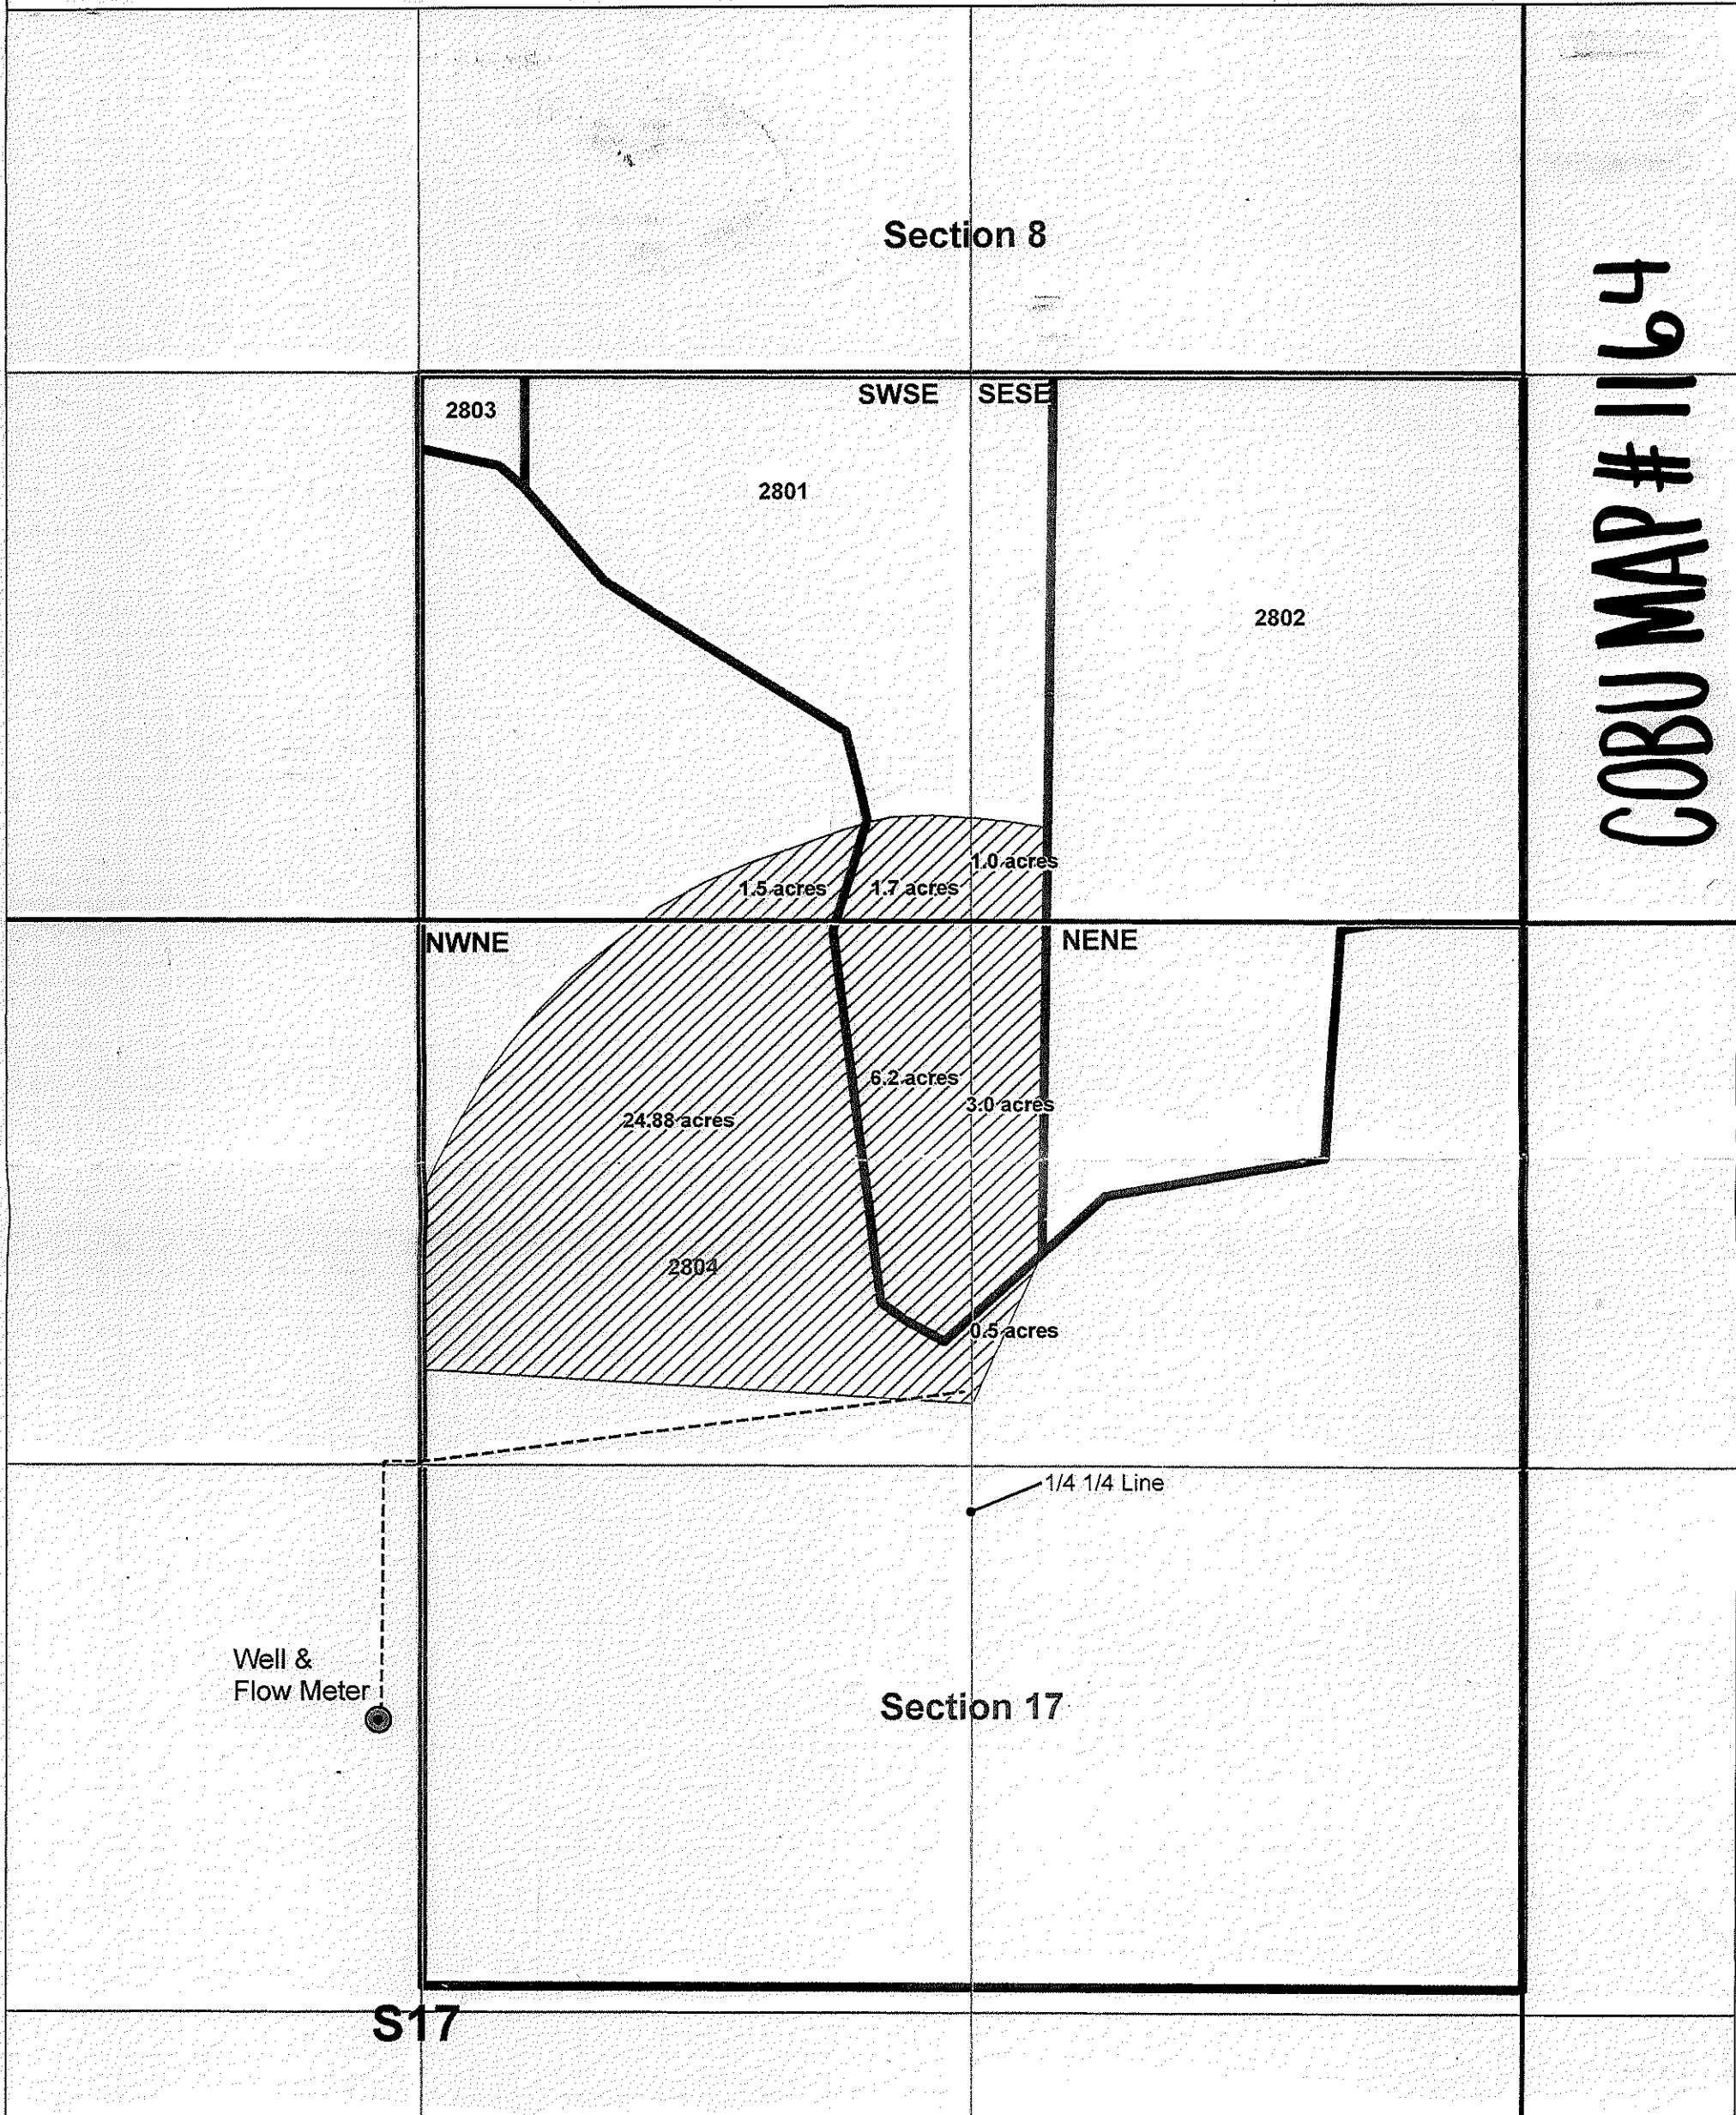


### Legend

- Well & Flow Meter
- 10 in. Buried Main Line
- Place of Use
- Tax Lot


### POA LEGAL DESCRIPTIONS:

**Well (UNIO 52441)**  
 SENW, Section 17, T3S, R39E, W.M.; being 708' N and 104' W from the center of Section 17, T3S, R39E, W.M.

### Certified Water Rights Examiner Stamp

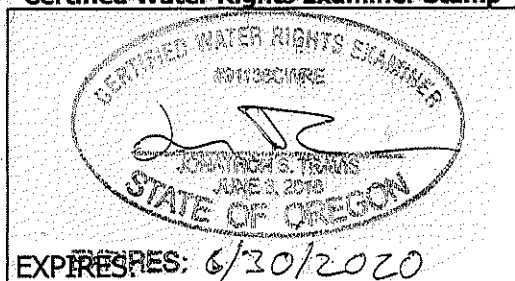

Scale: 1:4,800 (1" = 400')

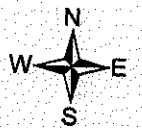

RECEIVED

JAN 14 2019

OWRD

### Disclaimer:

This map was prepared for the purpose of identifying the location of a water right only and it is not intended to provide legal dimensions or location of property lines.

### Map Notes:

Date: 11/15/2018  
 Coordinate System: NAD 1983 StatePlane Oregon North FIPS 3601 Feet  
 By: Will Anderson | will@anderson-geographics.com  
 Data: Anderson Geographics, Threemile Canyon Farms, State of Oregon

**anderson**  
GEOGRAPHICS