


Township 4 North, Range 32 East, W.M.
SW NE, SE NE, NE SE, NW SE, & SE SE
Section 35
Umatilla County

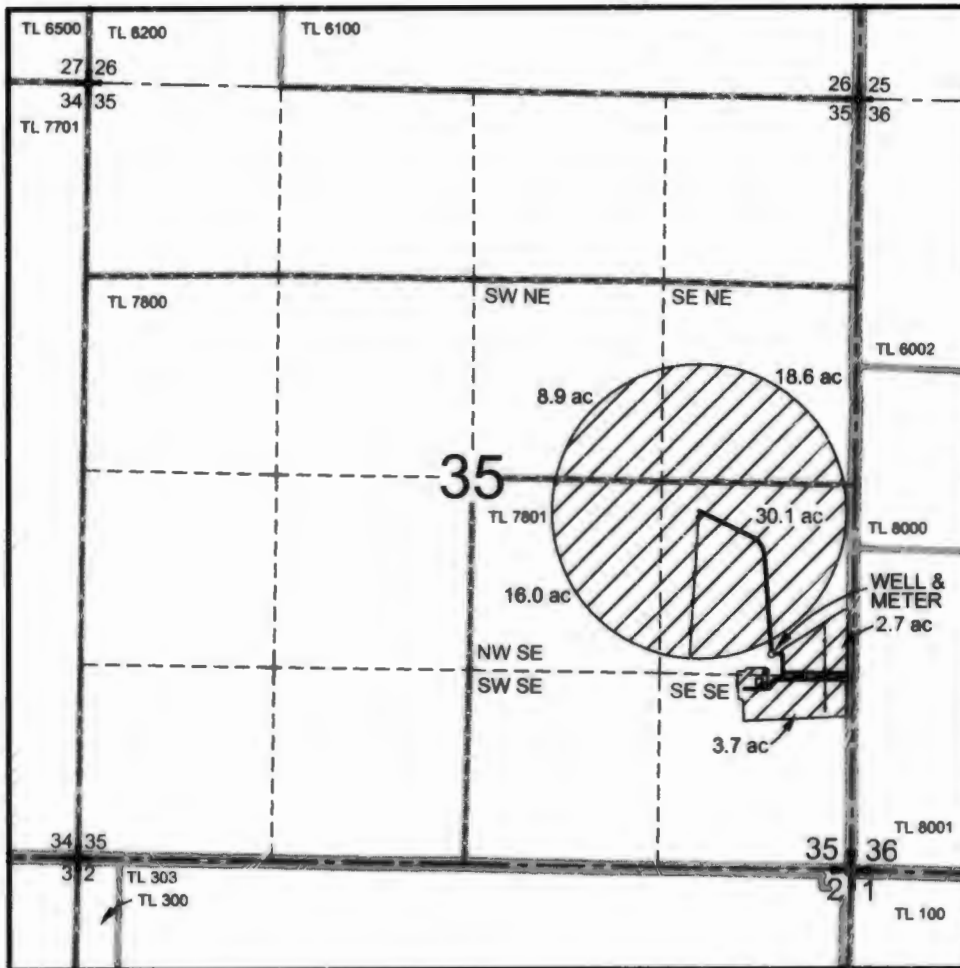

WELL: LOCATED 1534' NORTH AND 562' WEST FROM SE CORNER OF SECTION 35

LEGEND

- | | | | |
|---------|------------------|--|----------------------|
| --- | SECTIONS | | TAX LOTS |
| - - - - | QTR-QTR SECTIONS | | 80.0 ACRES IRRIGATED |
| — | BURIED PIPELINES | | |
| — | HANDLINES | | |
| — | CENTER PIVOT | | |

FINAL PROOF MAP
under
Application No. G-15278/T-11959
Permit No. G-17437
in name of
RICHIE HAMILTON
March 31, 2016



THIS MAP WAS PREPARED FOR THE PURPOSE OF IDENTIFYING THE LOCATION OF A WATER RIGHT ONLY AND IS NOT INTENDED TO PROVIDE LEGAL DIMENSIONS OR LOCATION OF PROPERTY OWNERSHIP LINES.

EXPIRES: 6/30/18