


Claim of Beneficial Use Map for Application S 70477 Permit S 53072 in the name of ACMPC Oregon 3, LLC

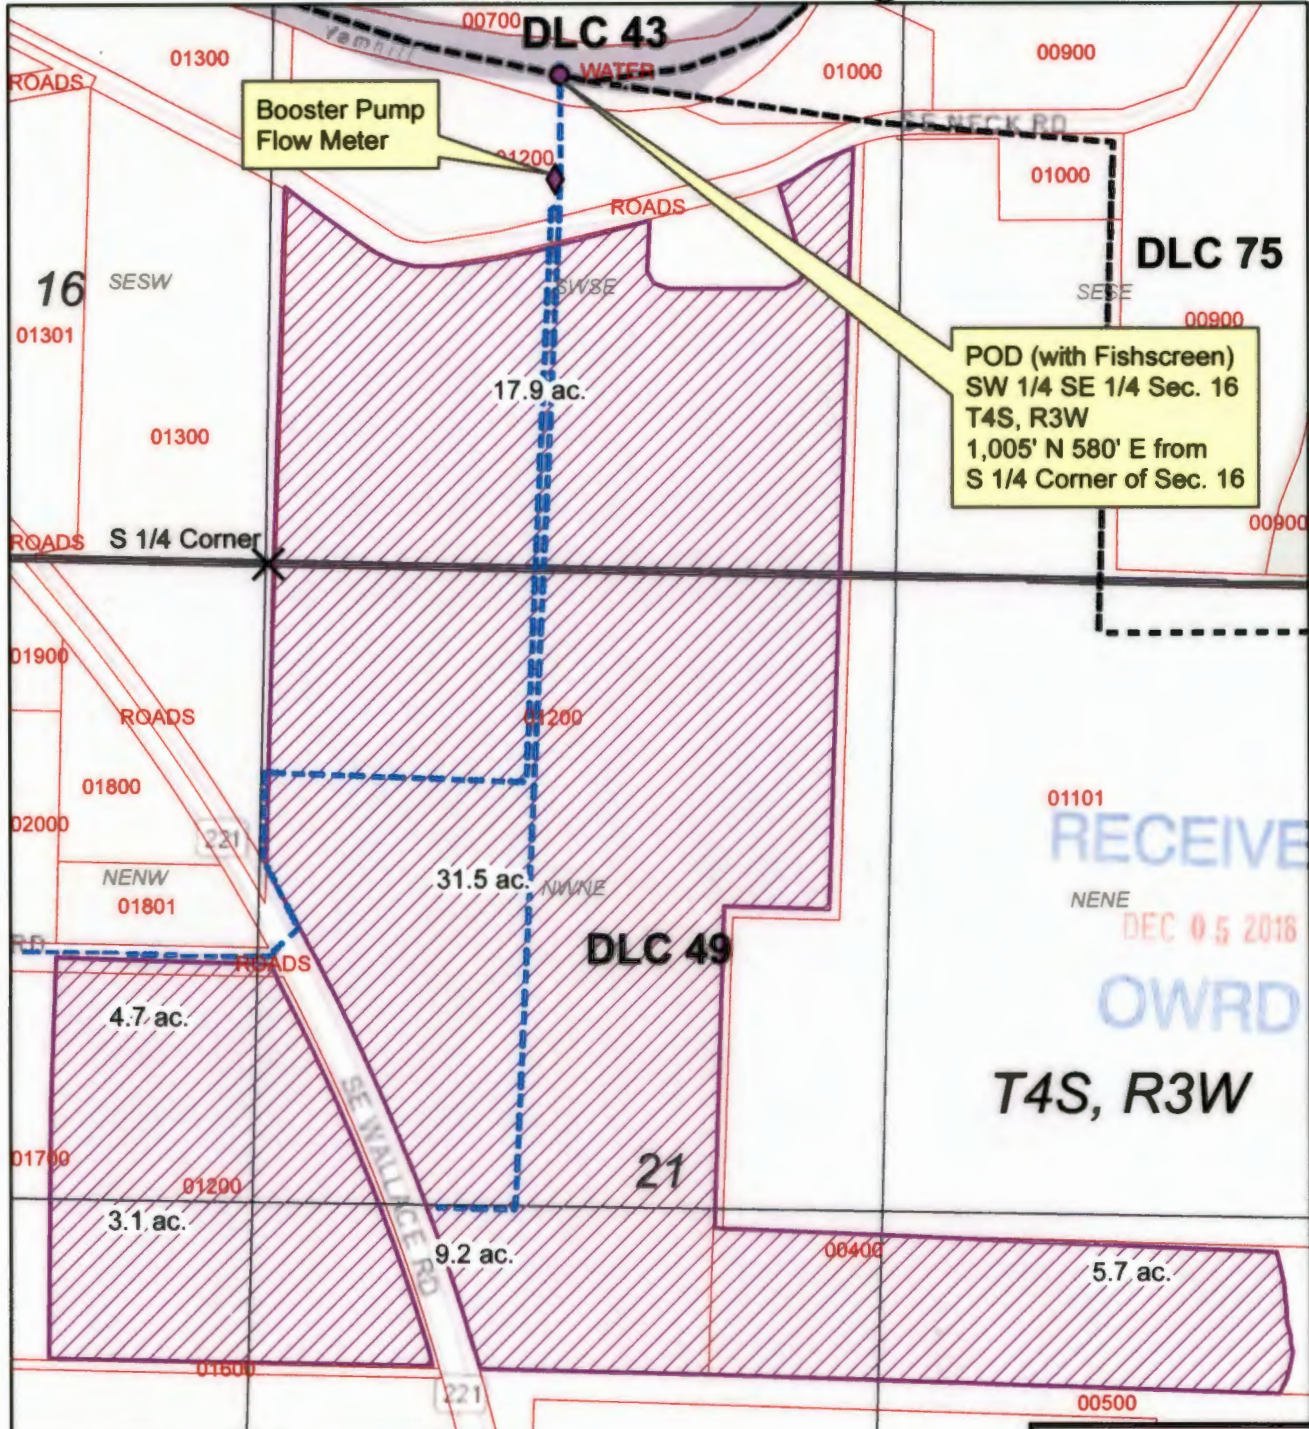

RECEIVED

DEC 05 2018

OWRD


T4S, R3W

CERTIFIED WATER RIGHT EXAMINER
 30680
William E. McGill
WILLIAM E. MCGILL
 MAY 3, 2011
STATE OF OREGON
 EXPIRES 12-31-2018

Legend

- Permit S 53072
- Mainline 6" pvc
- DLC
- Section
- QQ
- Taxlot

N
↑

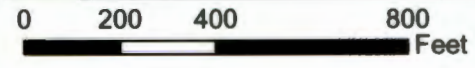

Esi, HERE, DeLorme, MapmyIndia, © contributors, and the GIS user commur

This map is not intended to provide legal dimensions or locations of property ownership lines.

Map prepared by McGill