


Nelson - Claim of Beneficial Use - T-6563

T14S, R2W

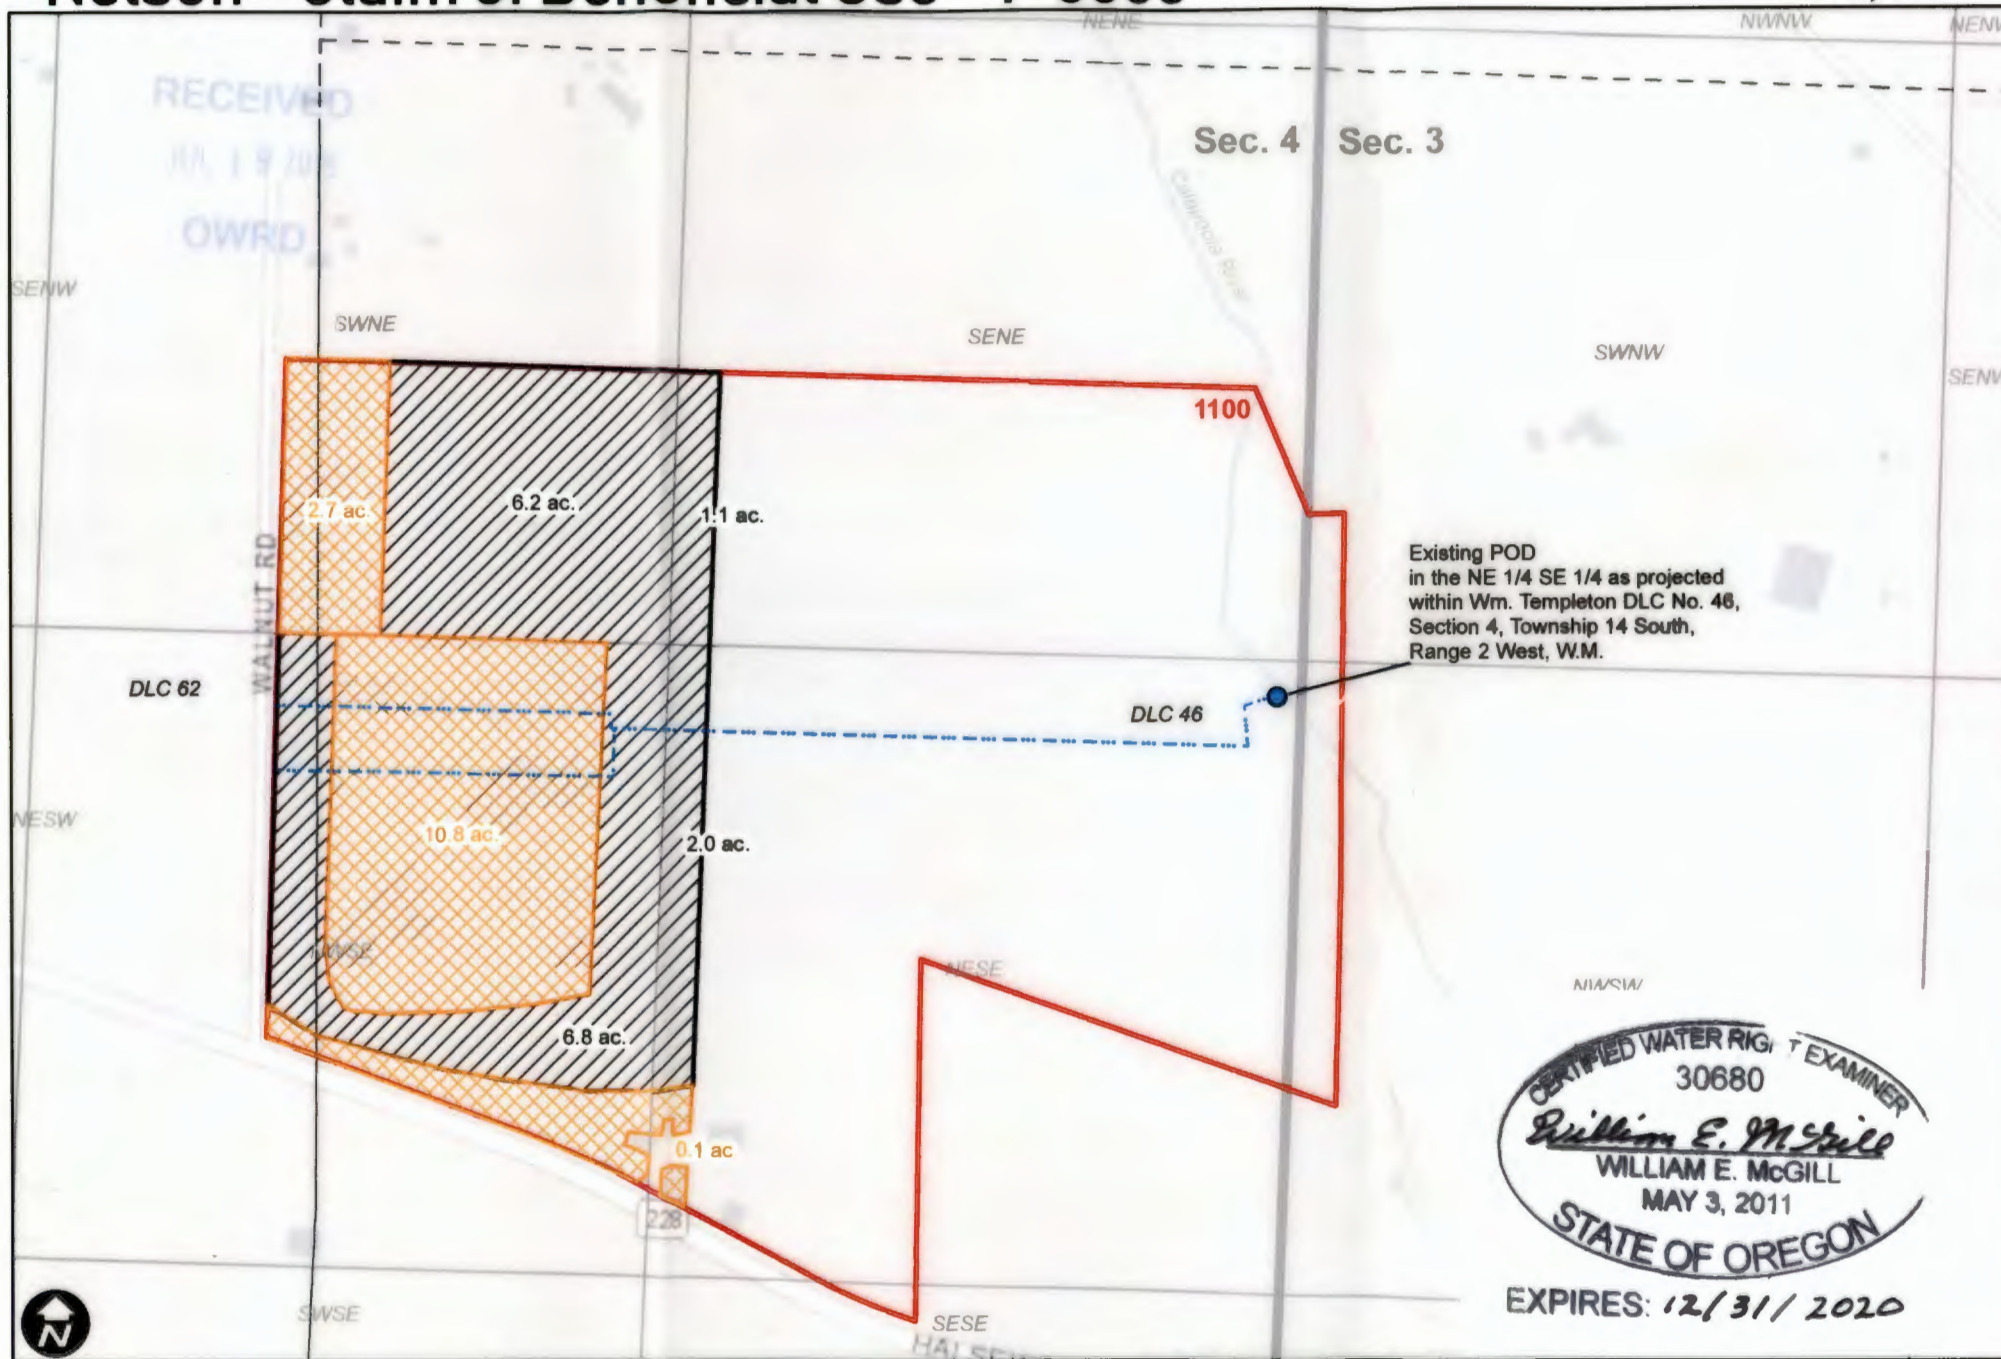

Changed POU under T-6563

 POU to revert

 Mainline

0 400 800 1,600 Feet

This map is not intended to provide legal dimensions or locations of property ownership lines.

WILL MCGILL SURVEYING, LLC | 15333 Pletzer Rd. SE, Turner, OR 97392
 503-510-3026, willmcgill.surveying@gmail.com