


# Nelson - Claim of Beneficial Use - T-6562

T14S, R2W

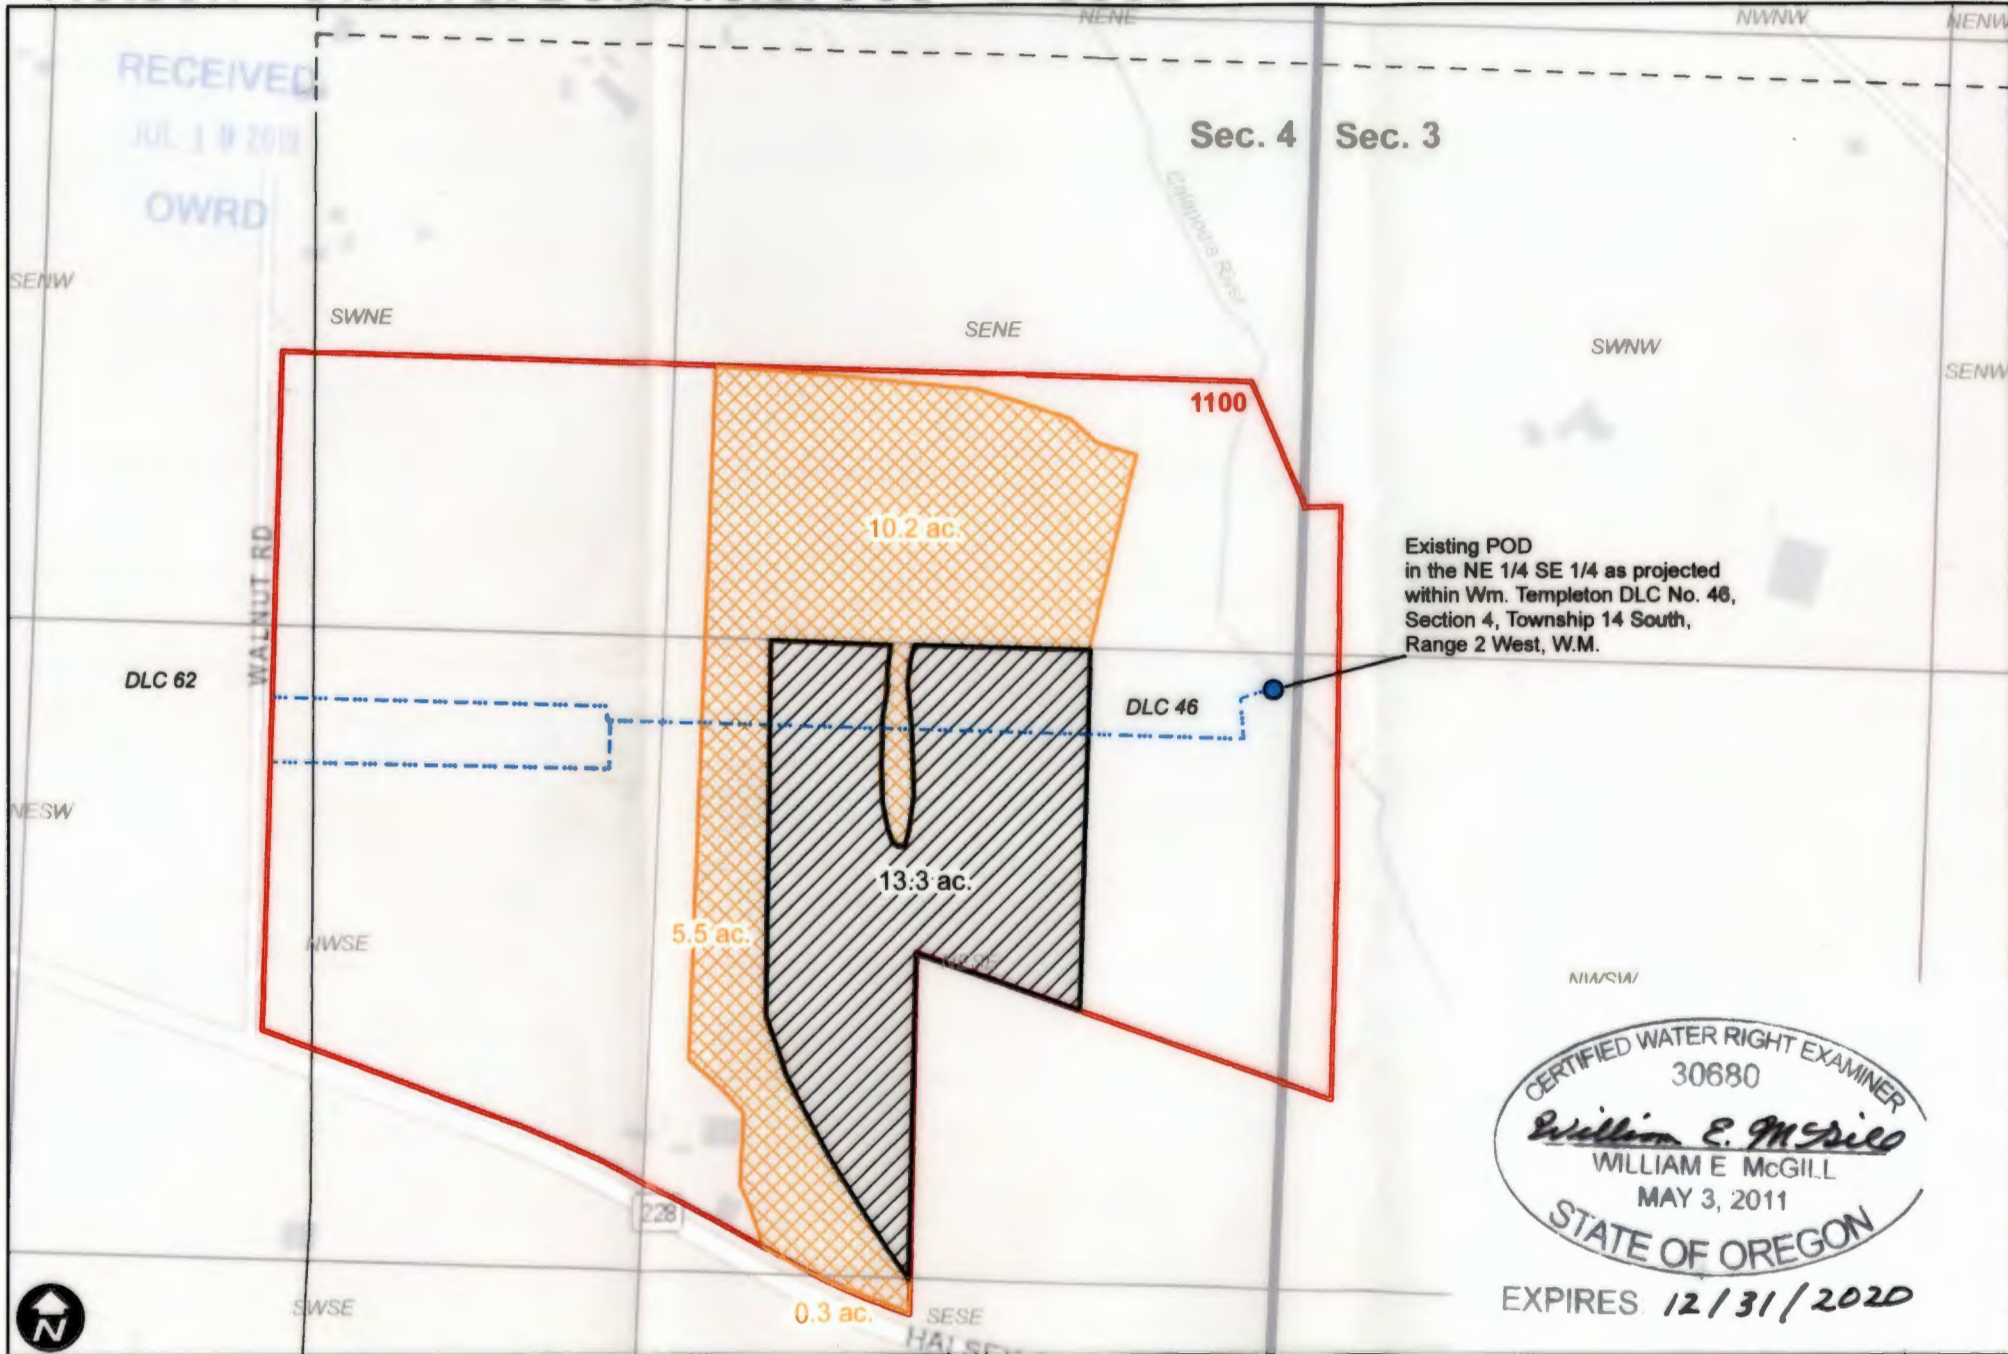

Changed POU under T-6562
  POU to revert
  Mainline

This map is not intended to provide legal dimensions or locations of property ownership lines.

**WILL MCGILL SURVEYING, LLC** | 15333 Pletzer Rd. SE, Turner, OR 97392  
 | 503-510-3026, willmcgill.surveying@gmail.com