

T.4S. R.1E. Section 30, W.M.

24 19
25 30


Lot 4 Lot 3

Fish
DLC 40

RECEIVED

NOV 22 2016

WATER RESOURCES DEPT
SALEM, OREGON

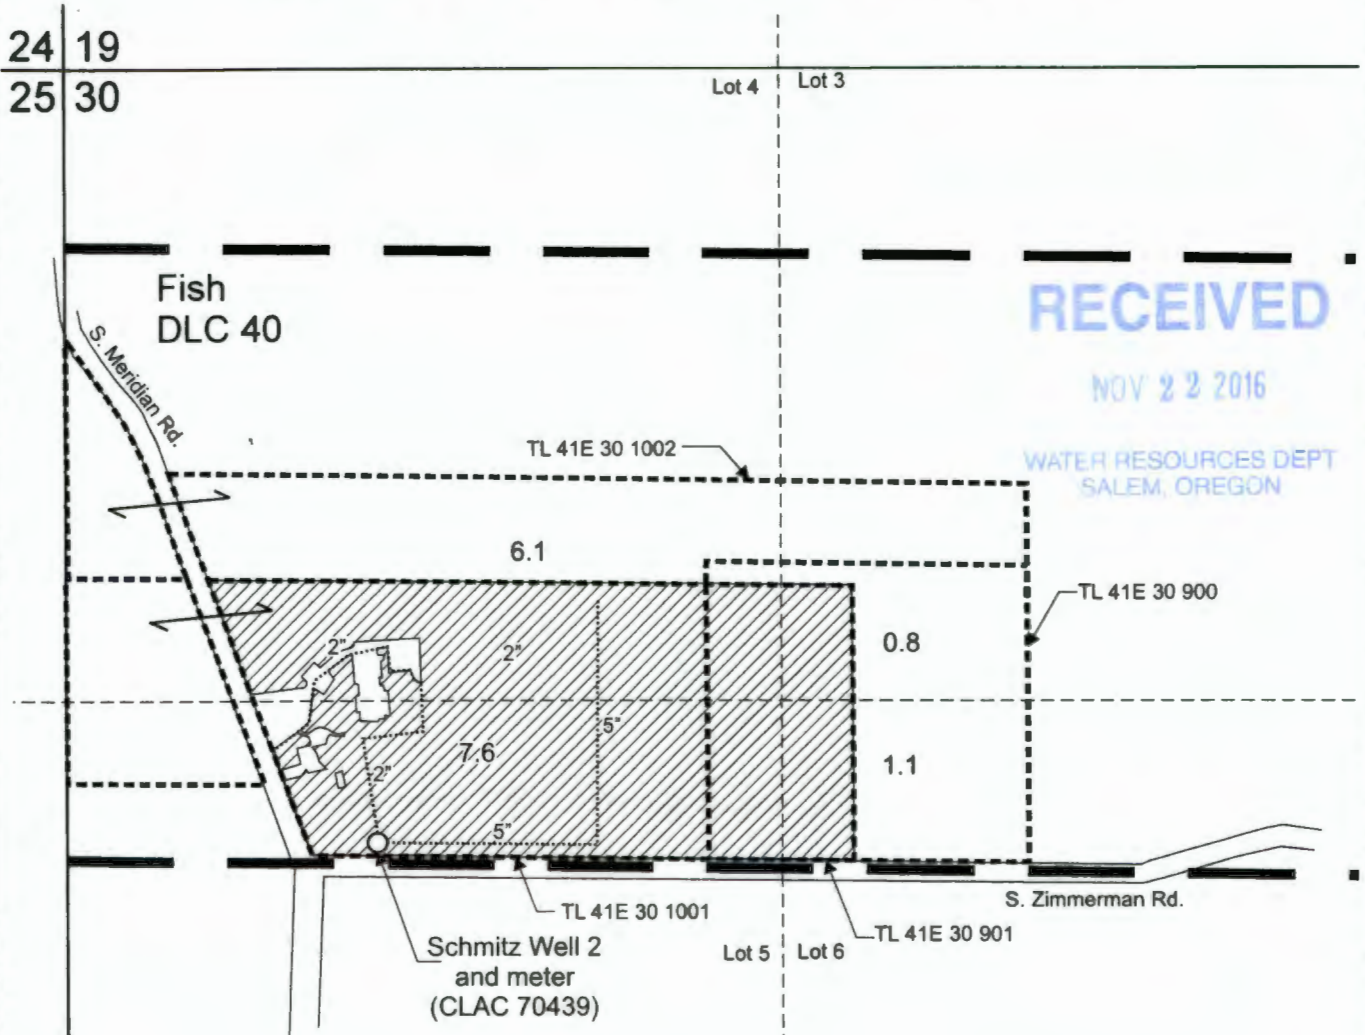

R.1W.
R.1E.

Schmitz Well 2 (CLAC 70439) is located 1,615 feet south and 655 feet east from the NW corner, Section 30.


Area (15.6 Acres) irrigated under Application G-15003, Permit G-17554.

Tax lot boundary

Donation Land Claim boundary

Irrigation mainlines

Scale: 1" = 400'

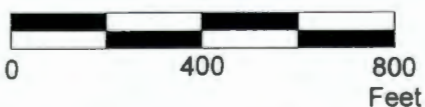

REVIEWED June 30 2017

This map was prepared for the purpose of identifying the location of a water right only and is not intended to provide legal dimensions or location of property ownership lines.

Claim of Beneficial Use Map
Application G-15003, Permit G-17554

John Schmitz and Lori Klinge Schmitz
T.4S. R.1E. Section 30, W.M.

08/2016

Pacific Hydro-Geology Inc.