


T.4S. R.1E. Section 30, W.M.

24 19

25 30

Lot 4 Lot 3

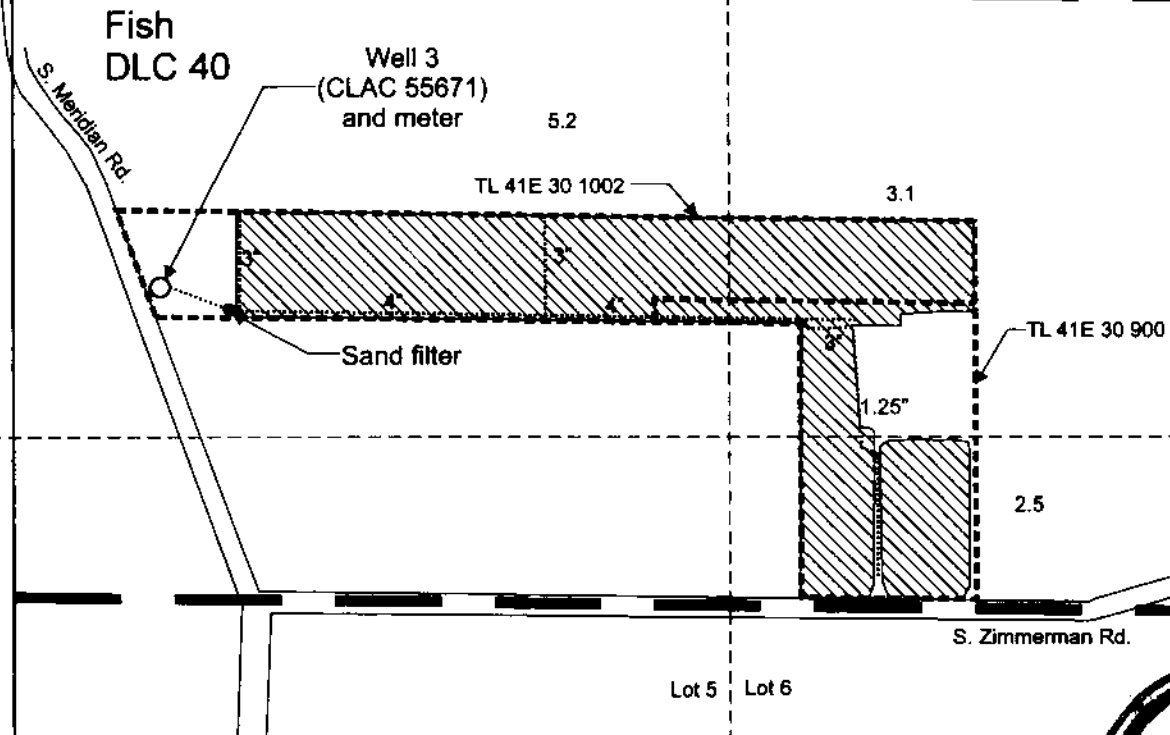

R.1W.
R.1E.

Well 3 (CLAC 55671) is located 1,000 feet south and 310 feet east from the NW corner, Section 30.


Area (10.8 Acres) irrigated by Application G-15003, Permit G-17555.

Tax lot boundary

Donation Land Claim boundary

Mainlines

Scale: 1" = 400'

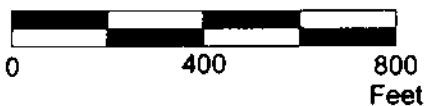

NOV 22 2017

CWRD

This map was prepared for the purpose of identifying the location of a water right only and is not intended to provide legal dimensions or location of property ownership lines.

Claim of Beneficial Use Map
Application G-15003, Permit G-17555

Vasily ad Marina Sharabarin
T.4S. R.1E. Section 30, W.M.

10/2017

Pacific Hydro-Geology Inc.



