

RECEIVED


JAN 28 2019

OWRD

FINAL PROOF MAP


T.3S.,R.2E.,W.M. SECTION 9

POINT OF APPROPRIATION LOCATED IN: TAX LOT 1300 OF CLACKAMAS CO. ASSESSORS MAP
WATER USE IN: TAX LOT 1300 OF CLACKAMAS CO. ASSESSORS MAP

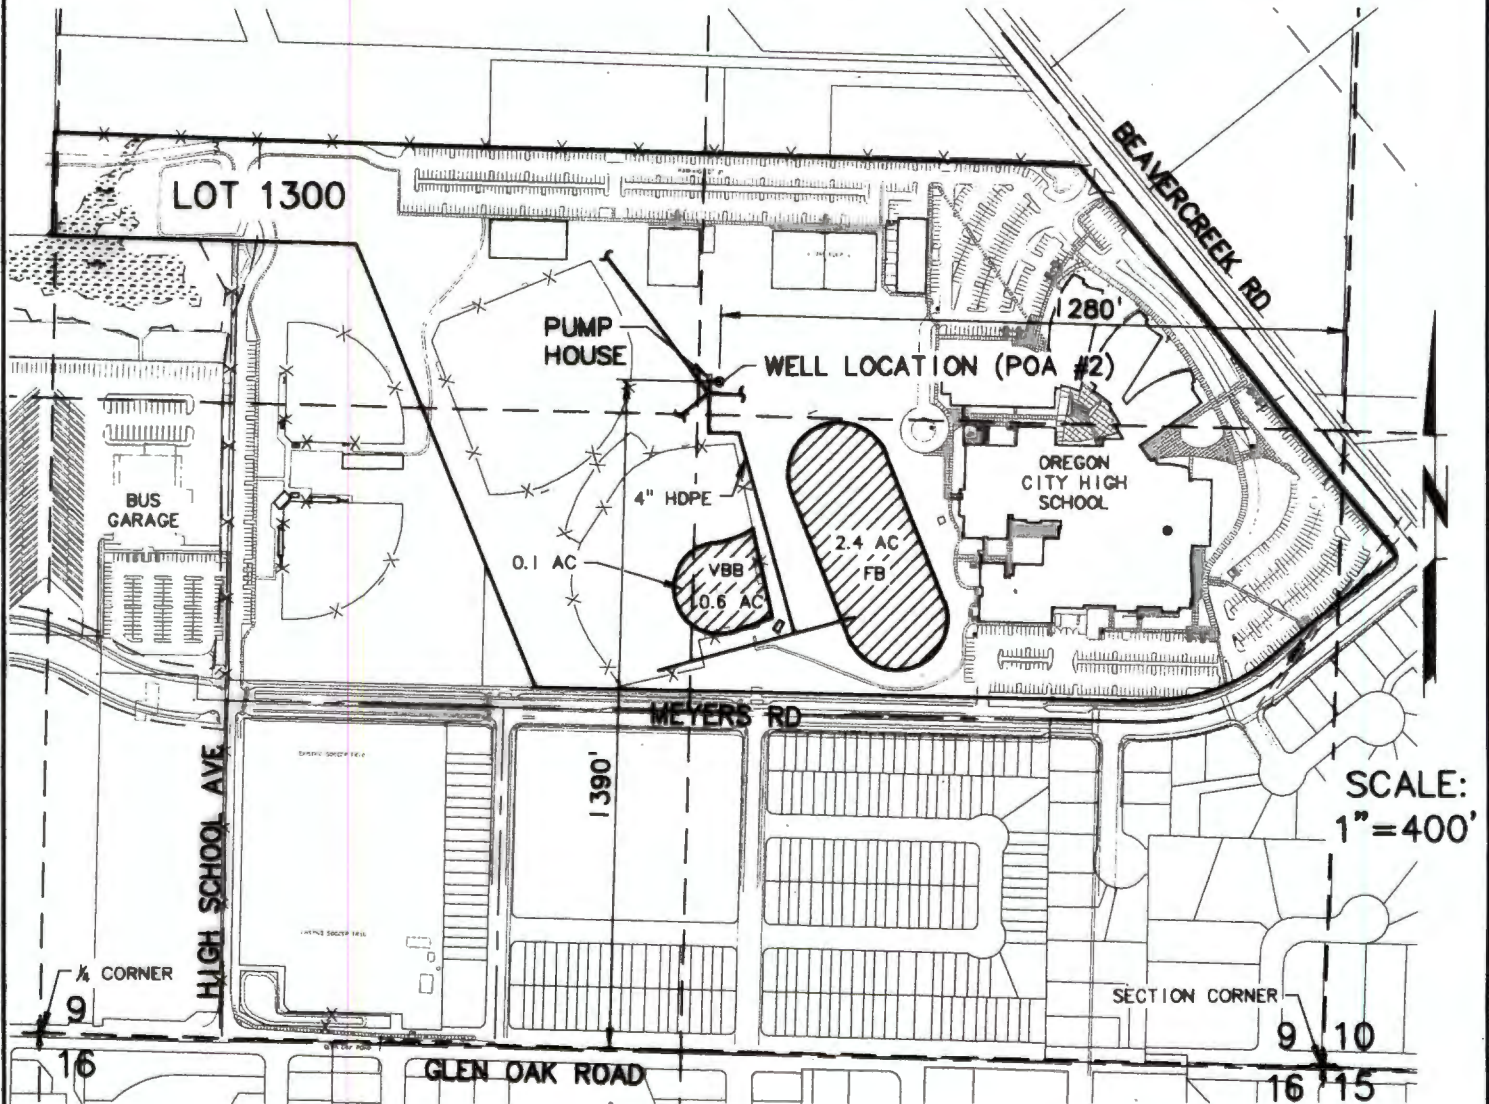


FINAL PROOF SURVEY FOR TRANSFER NO. T-12266

LEGEND

-  PLACE OF USE = 3.1 AC
- HDPE = HIGH DENSITY POLYETHYLENE
- FB = FOOTBALL FIELD
- VBB = VARSITY BASEBALL FIELD

IN THE NAME OF
 OREGON CITY SCHOOL
 DISTRICT NO. 62
 DECEMBER 2018

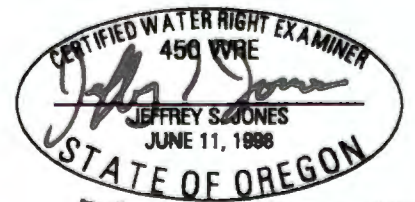

RENGWS 6.30.19

NOTE: THE PURPOSE OF THIS MAP IS TO IDENTIFY THE LOCATION OF THE WATER RIGHT. IT IS NOT INTENDED TO PROVIDE INFORMATION RELATIVE TO THE LOCATION OF PROPERTY OWNERSHIP BOUNDARY LINES.