


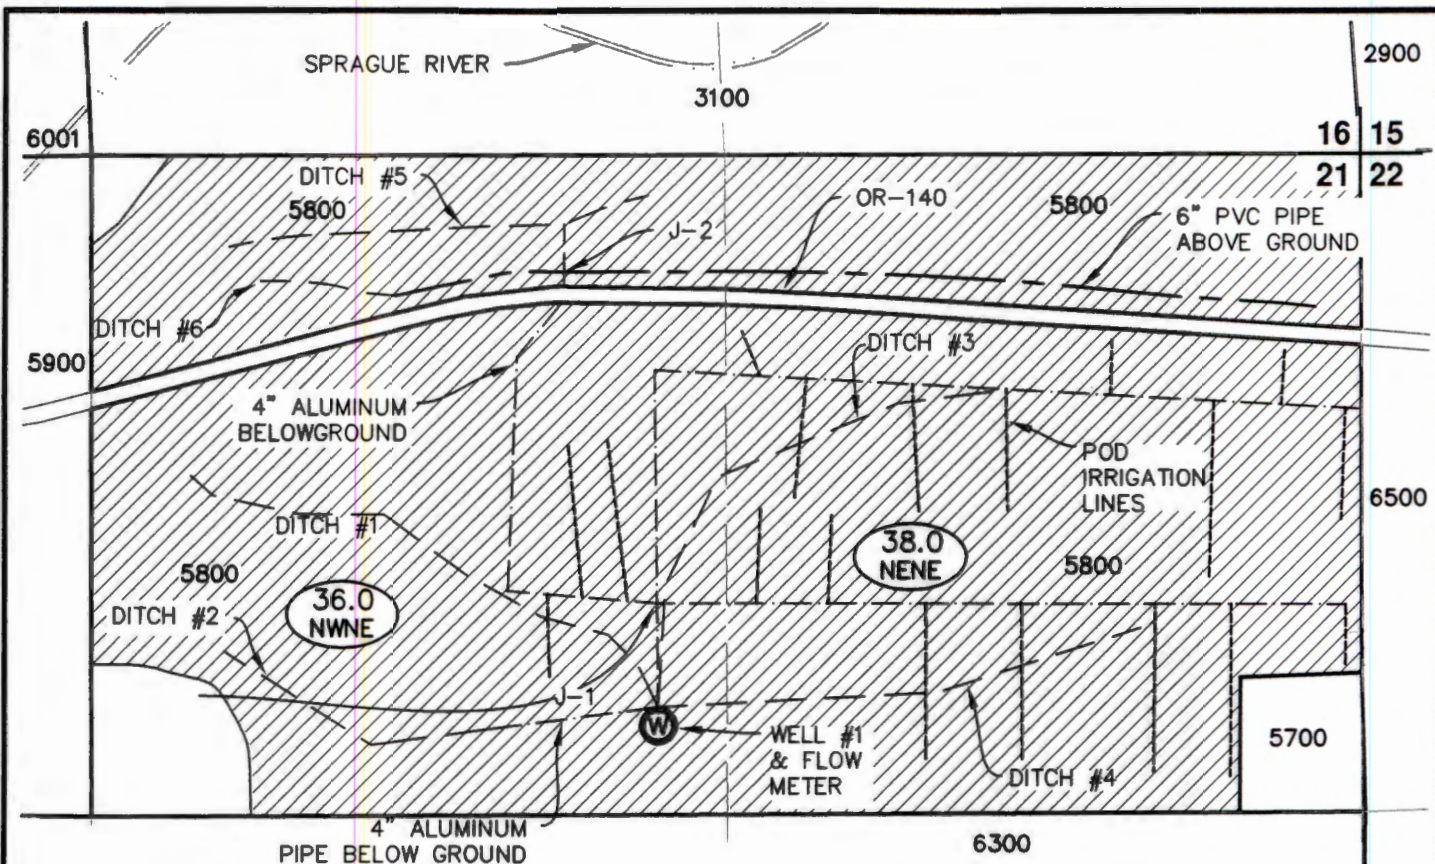

LEGEND

SECTION LINES

1/4 1/4 LINES

ROADS

RIVERS

TAX LOT BOUNDARY

IRRIGATION DITCH

K-LINE POD IRRIGATION LINES

BELOWGROUND PIPE

ABOVEGROUND PIPE

TOTAL ACRES IRRIGATED PER 1/4 1/4

36.0 NWNE

1/4 1/4 SECTION

1000 TAX LOT NUMBER





WELL

16 15
21 22

SECTION CORNER

RECEIVED
FEB 08 2018
OWRD

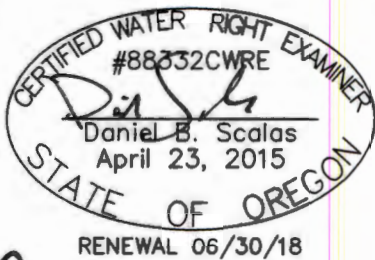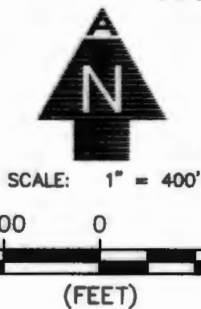

APPLICANT SIGNATURE

APPLICANT SIGNATURE

WELL TIE:

WELL IS LOCATED IN THE NW 1/4 NE 1/4 OF SECTION 21, T36S, R13E, W.M.; SOUTH 50' WEST 1907 FEET FROM THE NE CORNER OF SECTION 21.

NOTES:

1. THIS MAP WAS PREPARED FROM FIELD MEASUREMENTS, NAIP 2005 AERIAL PHOTOGRAPH, KLAMATH COUNTY TAX MAP 36 13.
2. THE PURPOSE OF THIS MAP IS TO IDENTIFY THE LOCATION OF THE WATER RIGHT ONLY, AND IS NOT INTENDED TO PROVIDE LEGAL DIMENSIONS OR LOCATIONS OF PROPERTY OWNERSHIP.
3. FOR TAX LOT INFORMATION, SEE TAX MAP INCLUDED WITH THIS APPLICATION.
4. DATE OF PRIORITY FOR THIS APPLICATION IS MARCH 30, 1999.

ADKINS

CONSULTING
ENGINEERING, LLP

Engineers ▲ Planners ▲ Surveyors

1435 Esplanade Ave · Klamath Falls, Oregon 97601 · (541) 884-4666 · FAX (541) 884-5335
Oregon · California

1/30/2018

3345-01

CLAIM OF BENEFICIAL USE AND FINAL PROOF MAP

FOR
CHARMAINE & ANTHONY EDWARDS
T36S, R13E, SEC. 21, W.M.
KLAMATH COUNTY, OREGON
APPLICATION NUMBER: G-14958
PERMIT NUMBER: G-13749