


P:\23\23763001\CAD\00\POA\2376300100_POA Map.dwg TAB:1x17 Landscape Date Exported: 06/25/19 - 10:29 by hmar

T.4N, R32E, W.M.
Umatilla County, Oregon

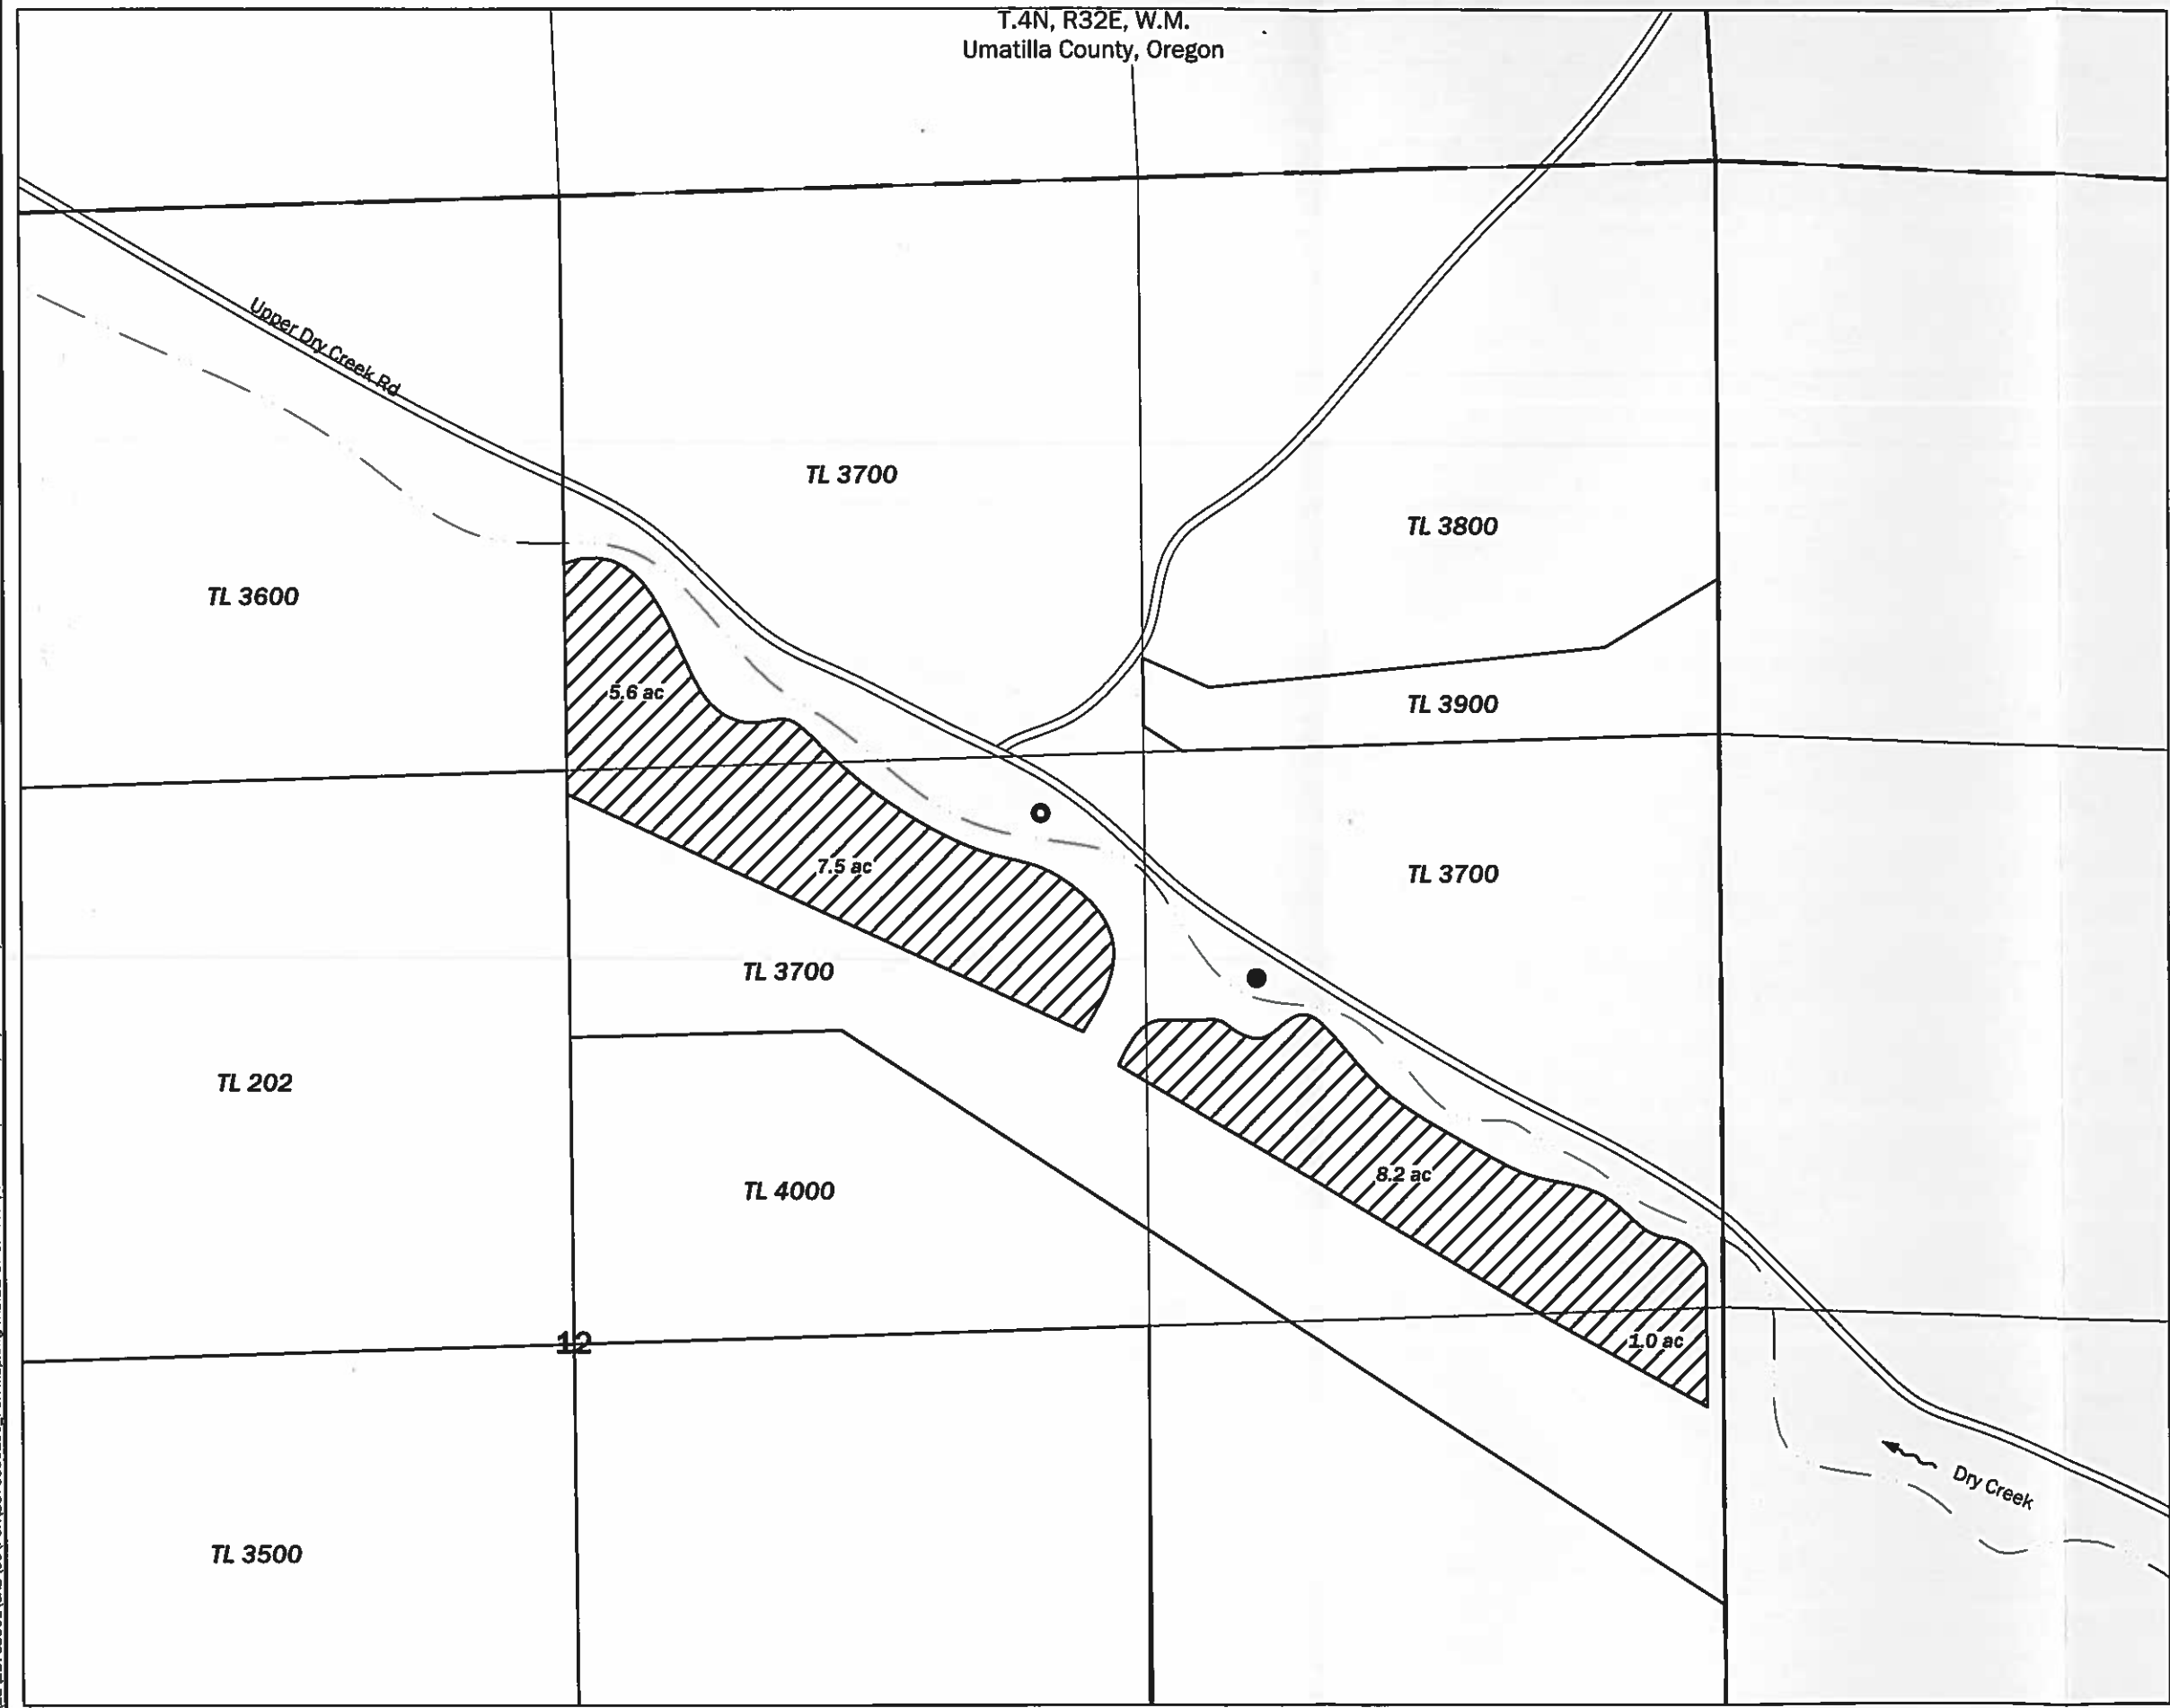

Historical Point of Appropriation Transfer Map
Certificate 40930
Permit # G-4682

Legend

- Authorized Point of Appropriation
- Historical Point of Appropriation
- ▨ Irrigated Area

Point of Appropriation Location


Authorized Point of Appropriation (Well 1)
Located 1720 feet South and 1620 feet East from the N 1/4 corner, section 12.
Historic Point of Appropriation (Well 2)
Located 1459 feet South and 1102 feet East from the N 1/4 corner, section 12.

Disclaimer

This map was prepared for the purpose of identifying the location of a water right only and it is not intended to provide legal dimensions or location of property ownership lines.

Map Notes

Date: 11/13/17
Data Sources: Umatilla County Taxlot Maps
Prepared By: GeoEngineers

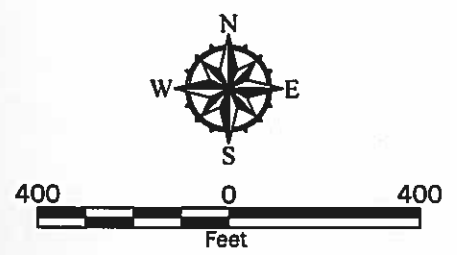

RECEIVED
JUN 27 2019
OWRD

GEOENGINEERS