


Crook County

T 14S R 16E Sec. 28 Tax Lot 1601

NE Of The NW




ON Map

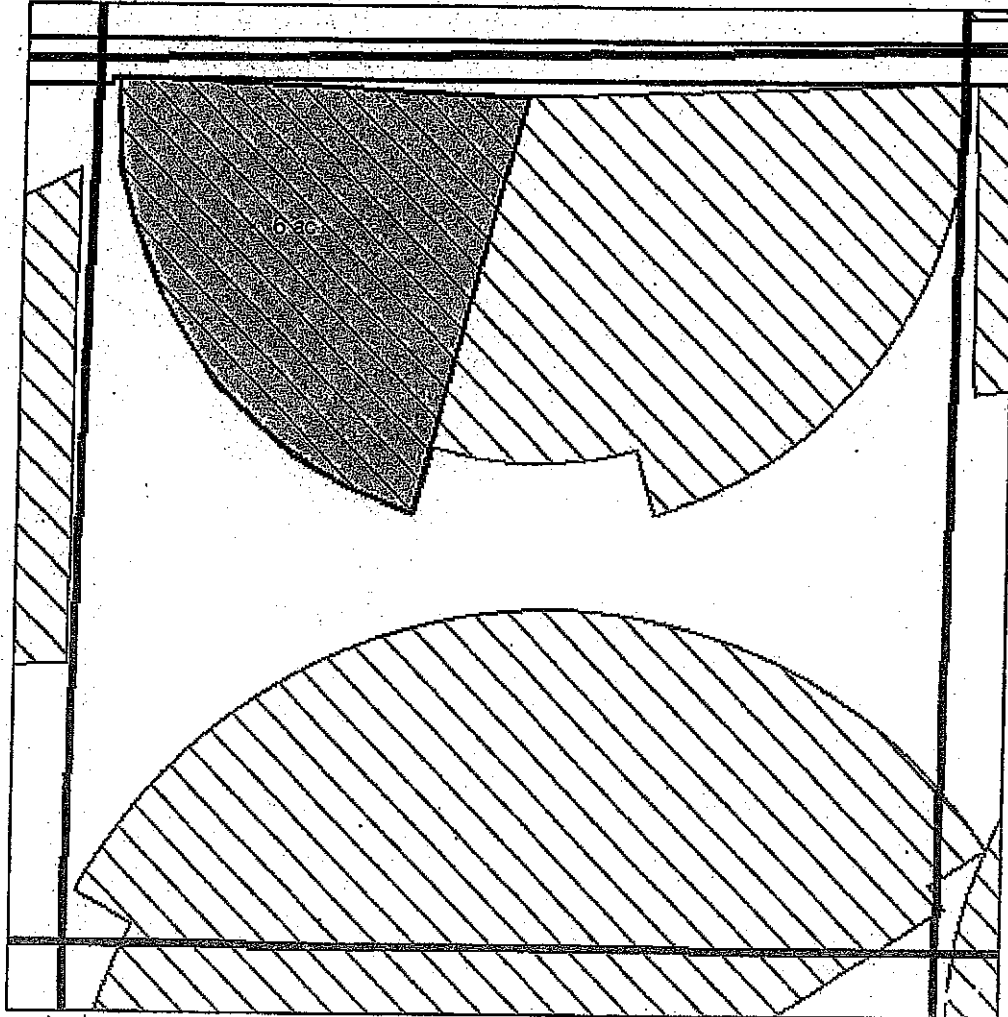

1 in = 400 ft

Certificate #: 82267 IS - 82268 IS

 Transfer

 Cert 82246 IR

*FINAL PROOF MAP - T-13091*

Debaca Land and Cattle Co

Acres: 6.0 acres On