


Sol Coast Consulting & Design, LLC
 Sustainable Building/Renewable Energy/Environmental Consulting
 Our Mission is to Support Strategic growth, responsible development, and sustainable living on the Southern Oregon coast.
 LICENSED, BONDED, & INSURED: CE# 14208
 65431 Millcoma Ln., Coos Bay, OR 97420
 # 541-266-0877 www.solcoast.com

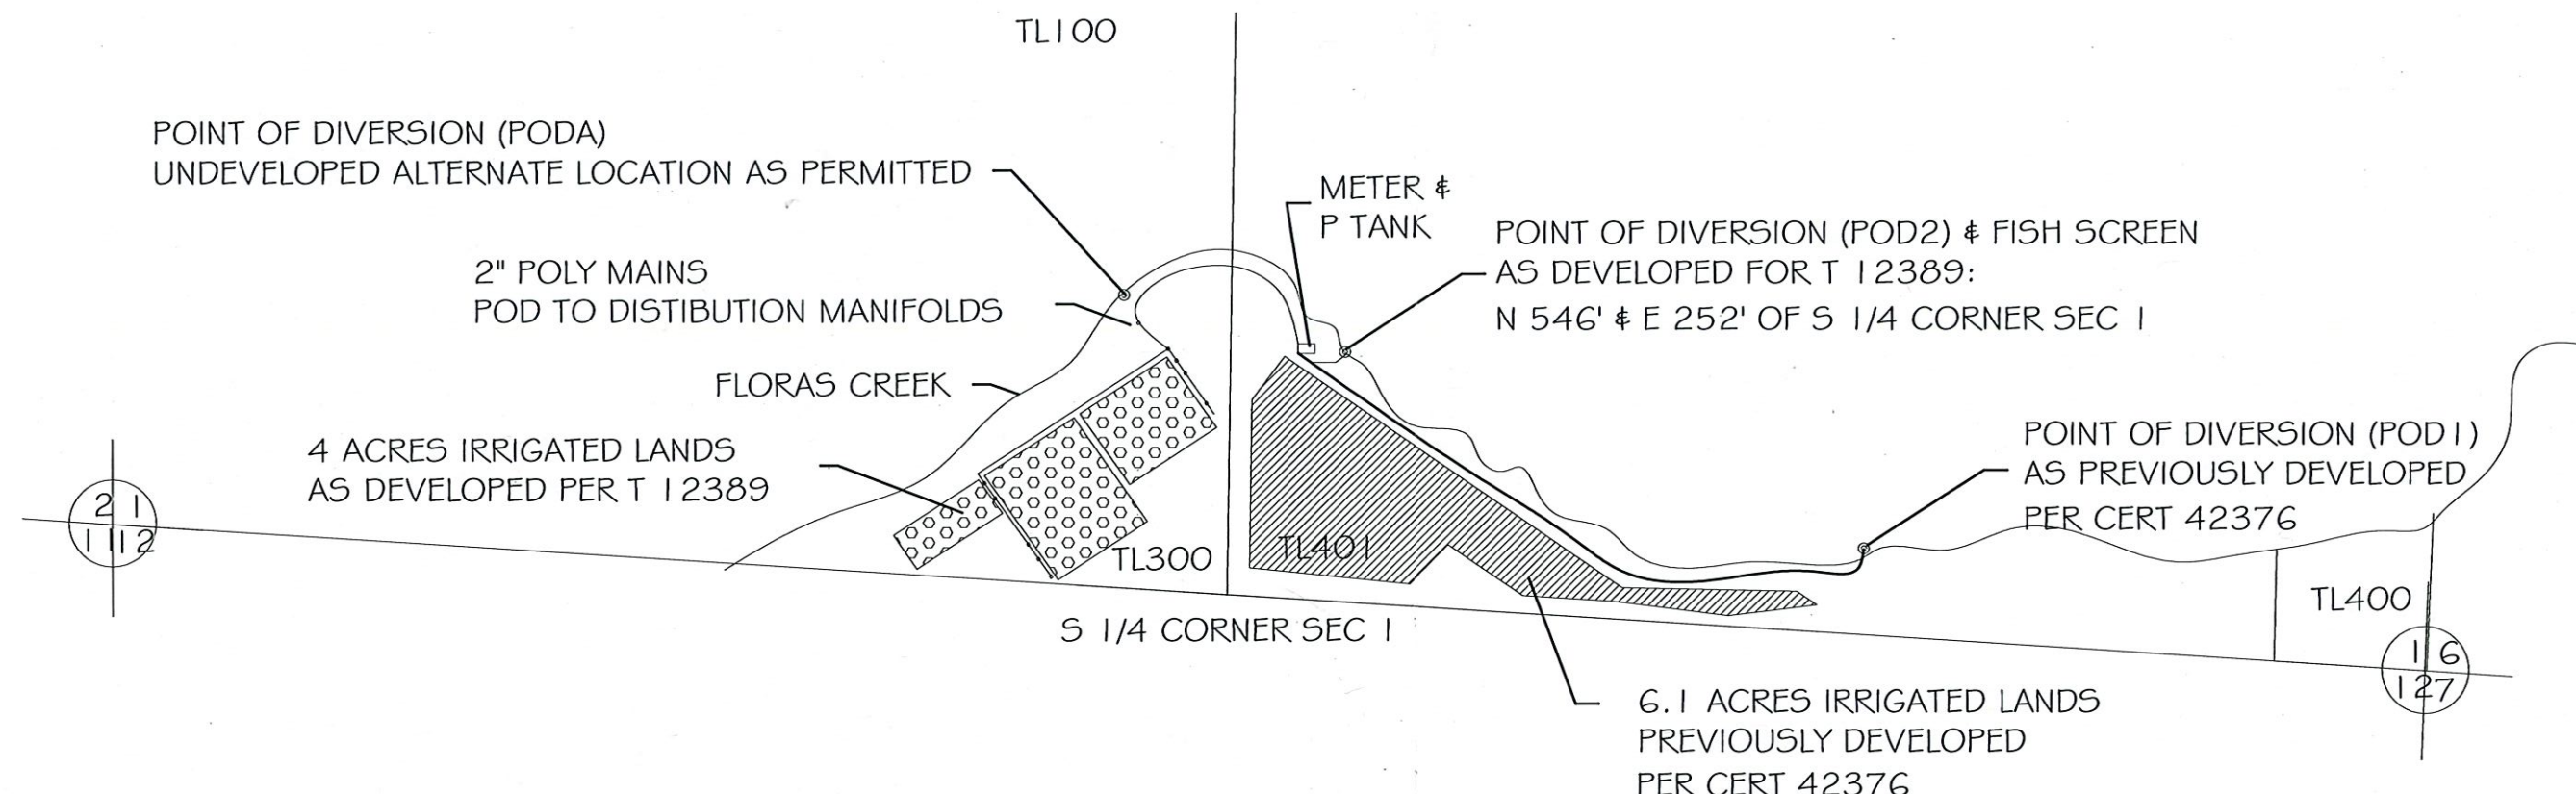


CLAIM OF BENEFICIAL USE
 WATER RIGHT TRANSFER T 12389
 ELIZABETH HARRISON, ET.AL.
 SEC 1 T 31S, R15 W
 TAX MAP 31 51 01

This map is not intended to provide legal dimensions or locations of property ownership lines.



EXPIRATION DATE: 6/30/2020

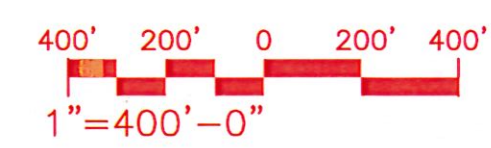

RECEIVED

SEP 13 2019

OWRD

Project Owner and Address

Groundswell Farms
 Floras Creek Rd
 Langlois
 Oregon

PROJECT	Groundswell Farms
ENGINEER	Souza
CHECKED BY	sms
DATE	9/6/2019
SCALE	As Noted

01