


# T6S R1E, WM

CLACKAMAS COUNTY

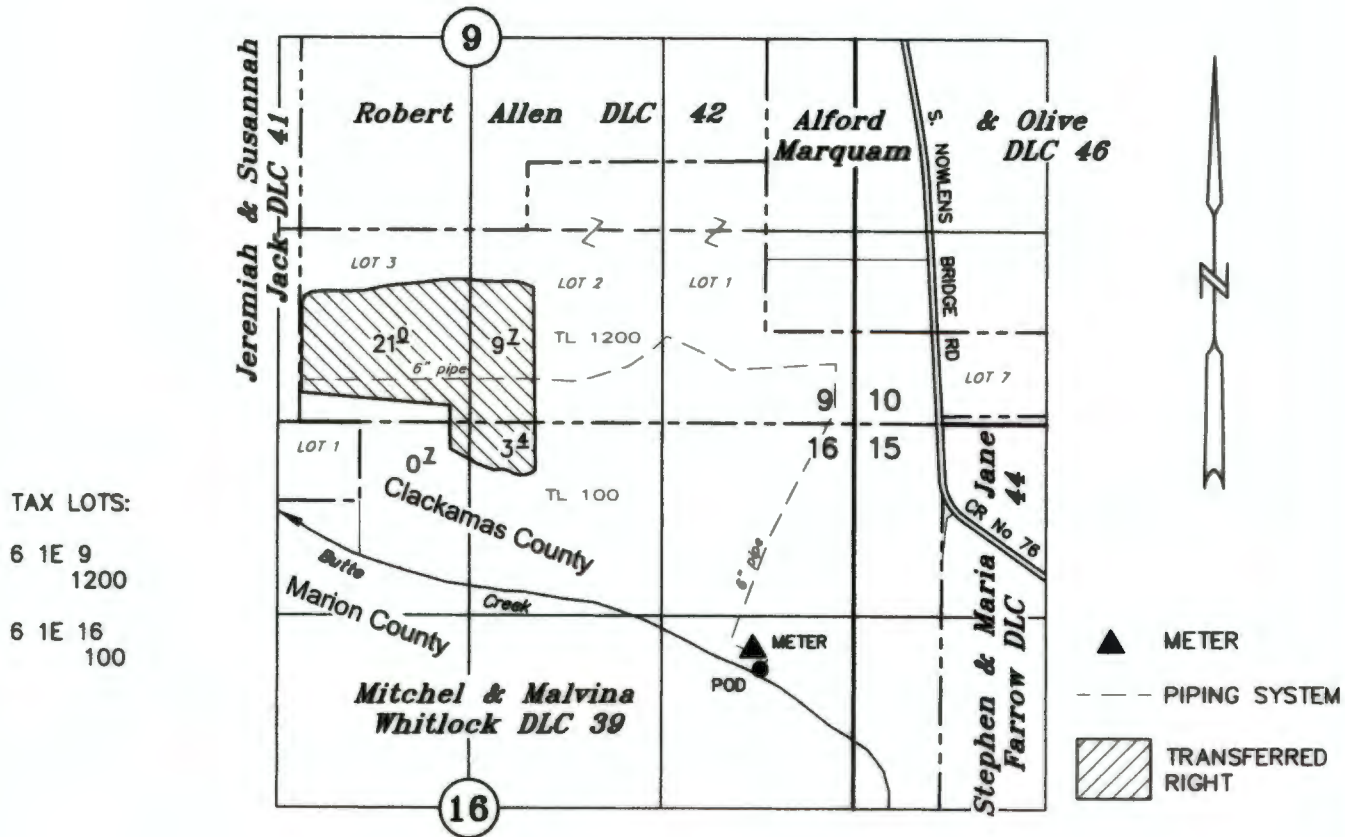

TAX LOTS:

6 1E 9  
1200

6 1E 16  
100

POD: 1620' South & 1240' West of NE Cor Mitchel & Malvina Whitlock DLC 39  
 METER: 1483' South & 1320' West of NE Cor Mitchel & Malvino Whitlock DLC 39

## Claim of Beneficial Use

Transfer No. T-12458

### Missouri Ridge Farms, LLC

September 6, 2019

SCALE: 1" = 1320'



NOTE: This map is for the purpose of identifying the location of water rights and has no intent to dimension or locate property ownership lines.

Renewal Date: December 31, 2019