


T. 25 S., R. 18 E., W. M.

RECEIVED

OWF

24 2019

OWRD

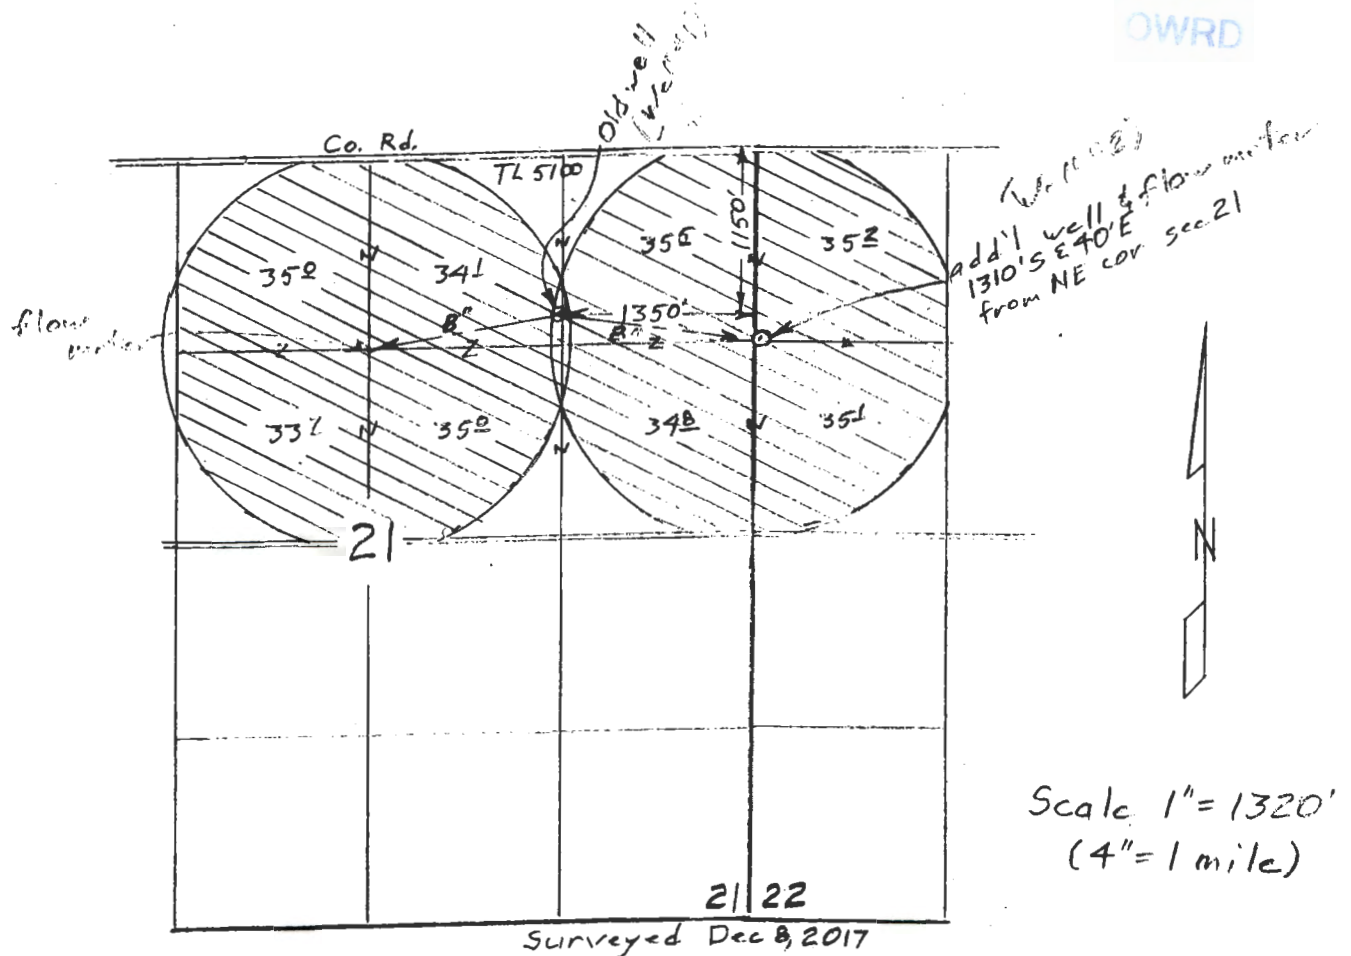

West pivot 137^B acres East Pivot 140^E acres

T-12385

Claim of Beneficial Use Map
for
Sinking Sand, LLC



This map is for the purpose of
locating a water right only
and has no intent to provide
legal dimensions or the location
of property lines.

ESTES SURVEYS, LLC

PO Box 17540 60382 Arnold Rd
Salem, OR 97305-7540 Bend, OR 97702
(503) 585-7500 (541) 382-7301