


T.7S., R.41E., W.M.

RECEIVED

MAY 10 2019


OWRD

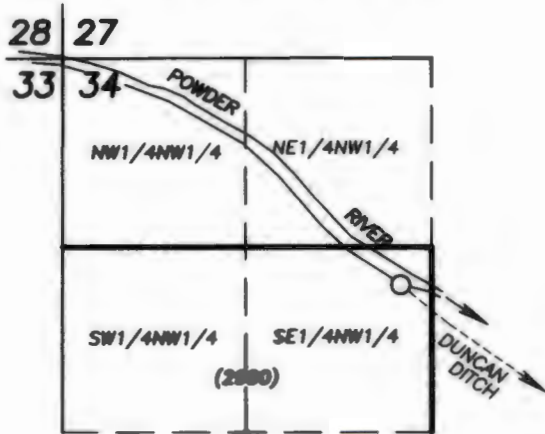

SCALE: 1"=1320'

- AUTHORIZED POD 1050 FT. NORTH & 2420 FT. EAST OF W1/4 COR. SEC. 34, T.7S., R.41E., W.M.

T.8S., R.42E., W.M.

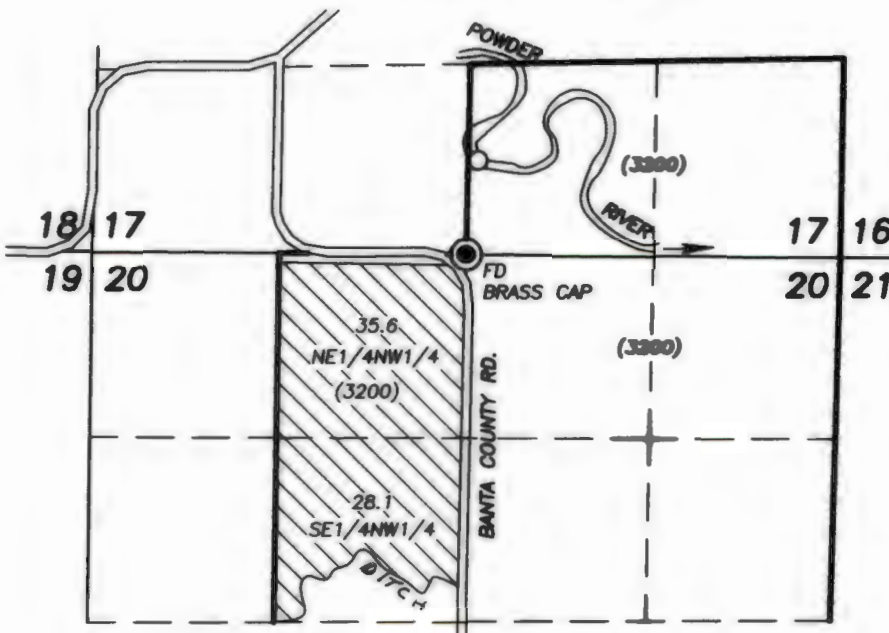

FINAL PROOF SURVEY  
 UNDER  
 TRANSFER-8740  
 SPECIAL ORDER VOL. 55, PAGE 1260

IN NAME OF  
 OLIVER AND CHRISTIE WILDE

PREPARED BY  
 ROBERT D. BAGETT  
 217 N. CANYON BLVD.  
 JOHN DAY, OR 97845


APRIL 4, 2019

- ADDITIONAL POD & FISH SCREEN 665 FT. NORTH & 85 FT. EAST OF SOUTH 1/4 COR. SEC. 17, T.8S., R.42E., W.M. FLOW METER BEARS S.31°W., 100 FT.

 PLACE OF USE

( ) TAX LOT

NOTE: THIS MAP IS NOT INTENDED TO PROVIDE LEGAL DIMENSIONS OR LOCATIONS OF PROPERTY OWNERSHIP LINES.

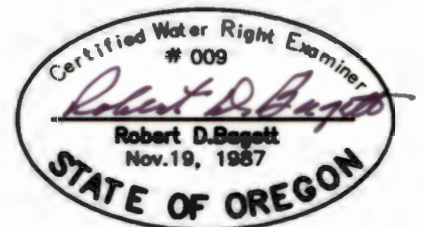

RENEWS 12/31/19