

CLAIM OF BENEFICIAL USE MAP


TO ADD PLACE OF USE &
POINTS OF APPROPRIATION
FOR APPLICATION G-16269

TAX LOTS: 3300 & 4200 IN SECTION 21,
TOWNSHIP 25 SOUTH, RANGE 31 EAST, W.M.

RECEIVED

JUN 01 2021

OWRD

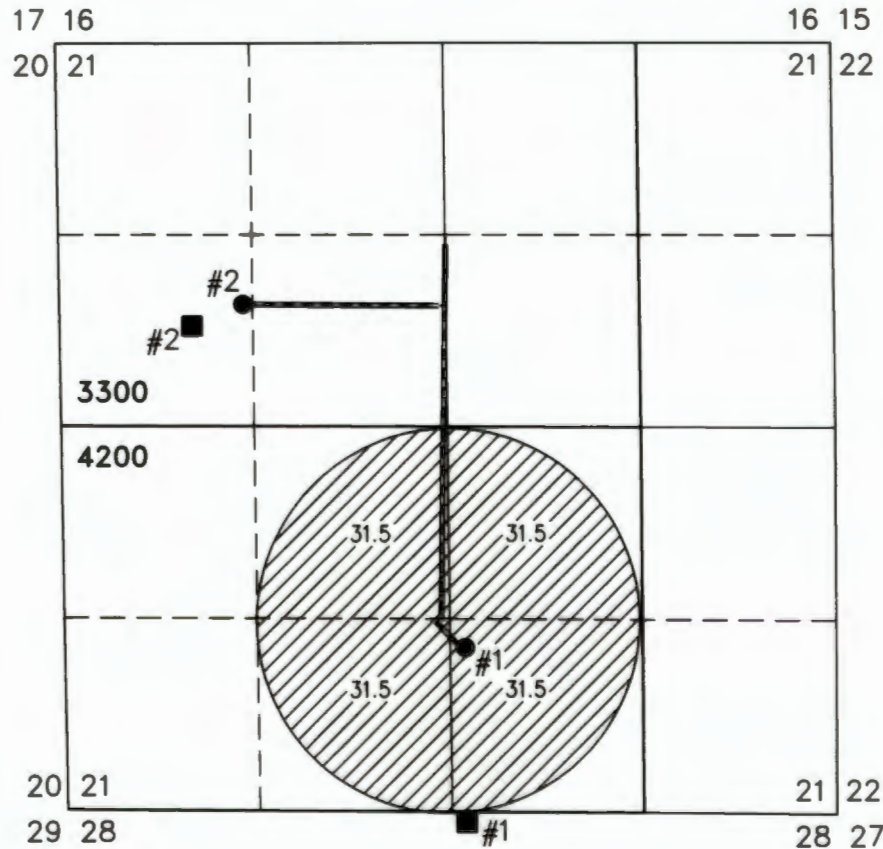


POWER METER #1

LOCATED 2710 FEET SOUTH AND 100 FEET EAST
FROM THE C 1/4 CORNER OF SECTION 21.

POWER METER #2

LOCATED 685 FEET NORTH AND 1740 FEET WEST
FROM THE C 1/4 CORNER OF SECTION 21.

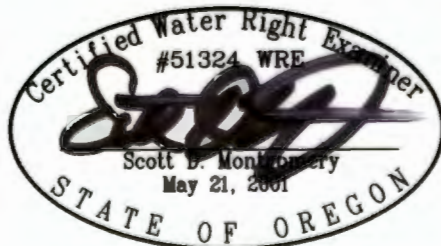


RENEWAL DATE: 12/31/2022

#1 (HARN 50368)

- LOCATED IN THE SW 1/4 SE 1/4 SECTION 21, T25S R31E, W.M. AND 1510 FEET SOUTH AND 105 FEET EAST FROM THE C 1/4 CORNER OF SECTION 21.

#2 (HARN 50633)

- LOCATED IN THE SW 1/4 NW 1/4 SECTION 21, T25S R31E, W.M. AND 835 FEET NORTH AND 1390 FEET WEST FROM THE C 1/4 CORNER OF SECTION 21.

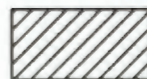

126.0 ACRES 'W' RIGHTS FROM #1 &
#2 PER G-15831, AS SHOWN.

THIS MAP IS FOR THE PURPOSE OF LOCATING A WATER RIGHT ONLY AND HAS NO
INTENT TO PROVIDE LEGAL DIMENSIONS OR THE LOCATION OF PROPERTY LINES.

PREPARED FOR:

OREGON DEPT. OF STATE LANDS
1645 NE FORBES ROAD, SUITE 112
BEND, OR 97701

PREPARED BY:



ALL POINTS ENGINEERING AND SURVEYING, INC.
P.O. BOX 767 TERREBONNE, OR 97760
(541) 548-5833 www.APEandS.com