


T 24 S, R 31 E, WM

RECEIVED

MAY 17 2007

WATER RESOURCES DEPT
SALEM, OREGON

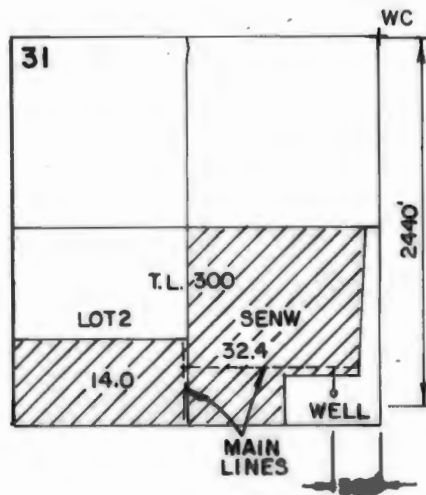

THERE NO METER AT THE WELL OR IN THE
PIPING SYSTEM - WATER USE CAN BE
MONITORED BY ELEC. USE PER ELEC.
METER 30' EAST FROM WELL.

THE PURPOSE OF THIS MAP IS TO
IDENTIFY THE LOCATION OF THE
WATER METER. IT IS NOT INTENDED
TO PROVIDE INFORMATION RELATIVE
TO THE LOCATION OF PROPERTY
OWNERSHIP.

INSPECTION DATE - 9-28-06

RECEIVED

OCT 13 2006

WATER RESOURCES DEPT
SALEM, OREGON

REVISED 5-14-07

CP Palmer

Chris T. Palmer No. 18, 1887 STATE OF OREGON RENEW 1-1-2007	FINAL PROOF SURVEY		
	UNDER APPLICATION G-15048 PERMIT G-13978		IN THE NAME OF NORTHWEST FARM CREDIT SERVICES, FLCA MARIO & ANTONIA RECANZONE
	Scale: 4" = 1 MILE	Date: SEPT 2006	Job: 2359
	Dsn: Dm: CHRIS Ckd:	M.A. PALMER & SONS, INC. ENGINEERING & SURVEYING 711 Ponderosa Village • Box 61 Burns, Oregon 97720	Sht. No. of 1