
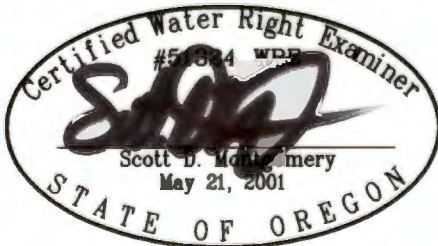


FINAL PROOF MAP

TO ADD PLACE OF USE &
POINT OF APPROPRIATION
FOR APPLICATION G-17489

TAX LOT: 4200 IN SECTION 23,
TOWNSHIP 26 SOUTH, RANGE 33 EAST, W.M.

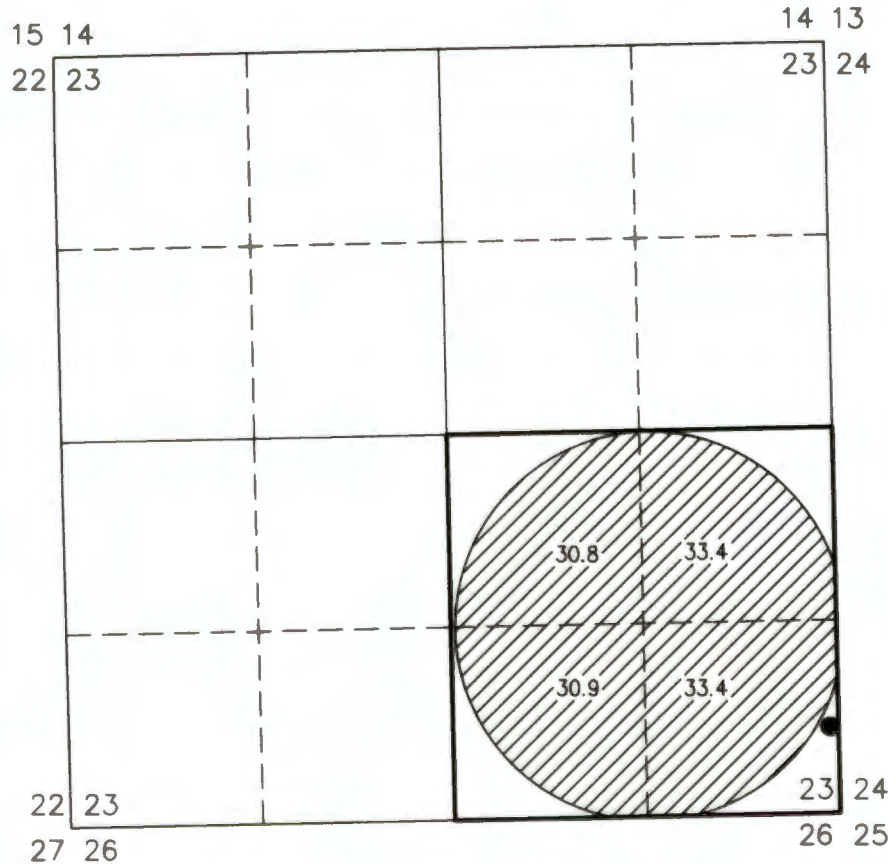

RENEWAL DATE: 12/31/2018

POA (HARN 51805)

LOCATED IN THE NE 1/4 NE 1/4 SECTION 23, T26S
R33E, W.M. AND 590 FEET NORTH AND 55 FEET
WEST FROM THE SE CORNER OF SECTION 23.
FLOW METER IS LOCATED 8 FEET WEST OF WELL.



128.5 ACRES 'W' RIGHTS FROM POA
PER G-16931, AS SHOWN.

RECEIVED BY OWRD

AUG 21 2017

SALEM, OR

THIS MAP IS FOR THE PURPOSE OF LOCATING A WATER RIGHT ONLY AND HAS NO
INTENT TO PROVIDE LEGAL DIMENSIONS OR THE LOCATION OF PROPERTY LINES.

PREPARED FOR:

STUART WILSON
21458 OAK LANE
AURORA, OR 97002

PREPARED BY:



ALL POINTS ENGINEERING AND SURVEYING, INC.
P.O. BOX 767 TERREBONNE, OR 97760
(541) 548-5833 www.APEandS.com