


**T23S, R32.5E,
SECTION 03, WM**


HARNEY COUNTY, OREGON

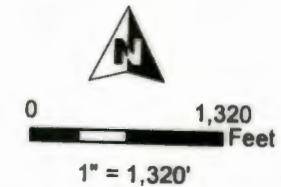

- POU Irrigation
- Township
- Section
- Quarter Quarter
- Tax Lot
- Well & Meter

WELL LOCATION:

1,275' S, 535' W OF C 1/4 COR SEC 03

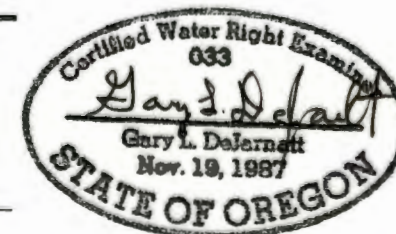

RENEWAL DATE 12/31/2019



34

HIGHWAY 20

T22S R32.5E

T23S R32.5E

KERRY RD

04

03

02

1300
37.1 AC
NWSW

34 AC
NESW

1100

NWSE

NESE

1400

COTTON TAIL LN

1500

1600

1700

1800

1900

SWSW

SESW

SWSE

SESE

10

CLAIM OF BENEFICIAL USE

Amanda Tyler

NOTE: THIS MAP IS NOT INTENDED TO
PROVIDE LEGAL DIMENSIONS OR LOCATIONS
OF PROPERTY OWNERSHIP LINES.

WATER RIGHT SERVICES, LLC

PO BOX 1830, BEND, OR 97709

CCB# 197121 www.oregonwater.us

541-389-2837 JOHNSHORT@USA.COM

AP G-17646

PERMIT G-17220

PROJECT #18009

MAY 27, 2018