



**T27S, R34E,
SECTION 16 & 15, WM**

HARNEY COUNTY, OREGON

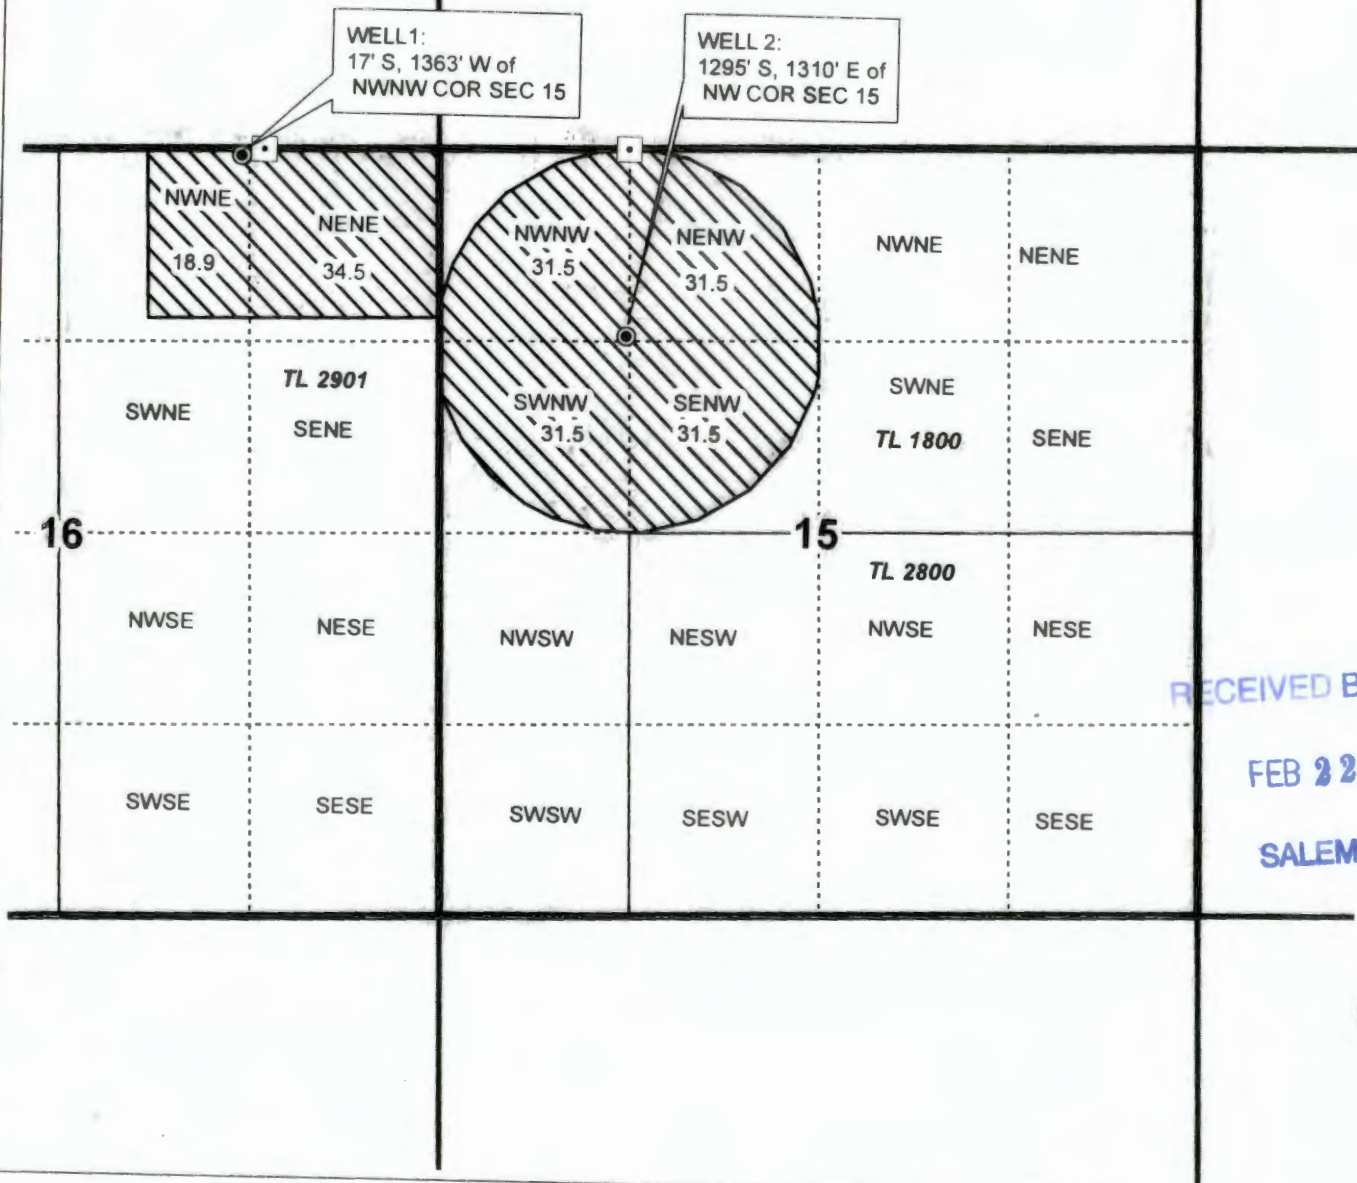

1 inch = 1,320 feet

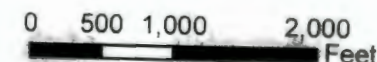


- POU, transfer ON
- Tax Lot
- Section
- Quarter Quarter
- Meter
- Well

RECEIVED BY OWRD

FEB 22 2017

SALEM, OR

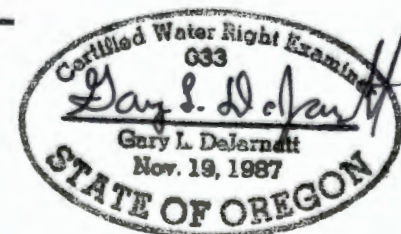

RENEWAL DATE 12/31/2017



Claim of Beneficial Use Map

Linda Neale

Application Number: G-12927

Permit G-12493

Date: 1/10/17

NOTE: THIS MAP IS NOT INTENDED TO
PROVIDE LEGAL DIMENSIONS OR LOCATIONS
OF PROPERTY OWNERSHIP LINES.

JOB # 16068

WATER RIGHT SERVICES, LLC

PO BOX 1830, BEND, OR 97709

CCB# 197121 www.oregonwater.us

541-389-2837 JOHNSHORT@USA.COM