


EXHIBIT B

T23S, R36E, W.M.
Harney County, Oregon

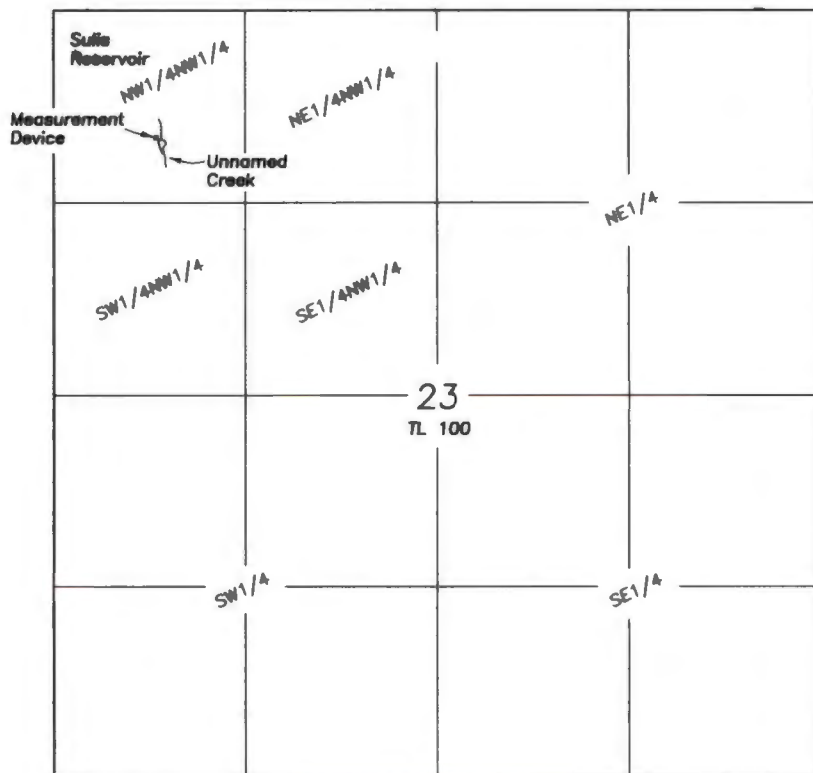

SCALE 1"=1320'

Outlet is located 900' South & 720' East of the
NW corner of Section 23.

Measuring device is located 17' North and 18' West of the outlet

FINAL PROOF SURVEY
CLAIM OF BENEFICIAL USE
SULIS RESERVOIR

For

Bureau of Land Management

August 24, 2017

LEGEND

Application No. R-86470
Permit No. R-14604
Priority 11/6/1992

A portion of Tax Lot
23-36 TL100

NOTE: Tax Lot 100 is owned by the BLM
and is more that 22,000 acres.
Therefore only a portion of the tax
lot boundary can be shown.

NOTE: The preparation of this map
was for the purpose of identifying
the location of the proposed water
right and has no intent to provide
dimensions or location of property
ownership lines.

RECEIVED

MAR 09 2018

OWRD

Prepared by
Cornerstone Surveying, Inc

P.O. BOX 33
JOHN DAY, OR. 97845
(541)575-1813

cornerstonesurvey@centurytel.net

