

CLAIM OF BENEFICIAL USE MAP



TO CHANGE PLACE OF USE AND
A POINT OF APPROPRIATION
FOR APP T-12680
HUFFORD ESTATE, LLC

RECEIVED

SECTION 24, TOWNSHIP 25 SOUTH, RANGE 14 EAST, W.M.
TAX LOT: 108 LAKE COUNTY, OREGON

SEP 09 2021

OWRD

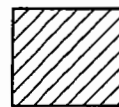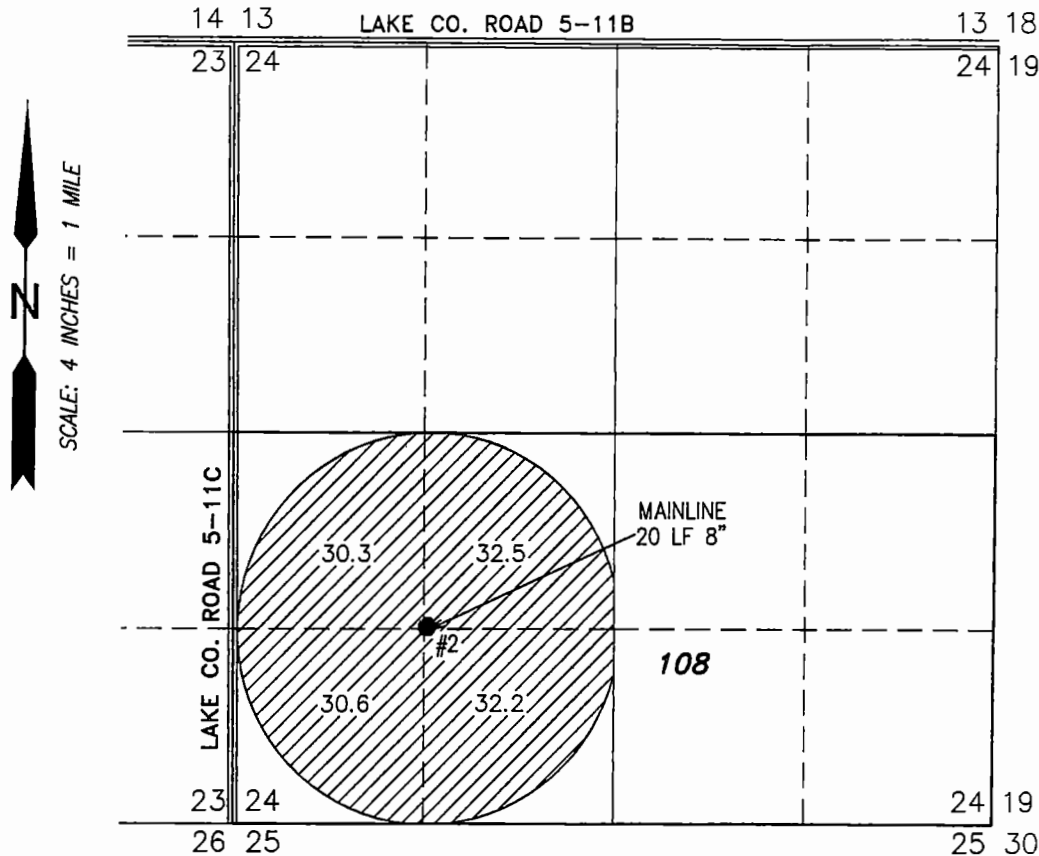

125.6 ACRES FROM #2 &
PERMIT G-7767, AS SHOWN

- #2 (PIVOT 6)
EXISTING WELL (LAKE 52398) TRANSFER: T-12680
1335' NORTH & 1335' EAST FROM THE SW CORNER
SECTION 24

RENEWAL DATE: 12/31/2022

METER IS LOCATED ON THE DELIVERY PIPE 12 FEET
NORTH OF THE WELL

THIS MAP IS FOR THE PURPOSE OF LOCATING A WATER
RIGHT ONLY AND HAS NO INTENT TO PROVIDE LEGAL
DIMENSIONS OR THE LOCATION OF PROPERTY LINES

PREPARED FOR:

HUFFORD ESTATE, LLC
P.O. BOX 99
FORT ROCK, OR 97735

PREPARED BY:



ALL POINTS ENGINEERING AND SURVEYING, INC.
P.O. BOX 767
(541) 548-5833
TERREBONNE, OR 97760
www.APEandS.com