


AVION WATER CO, INC.
CLAIM OF BENEFICIAL USE
PLACE OF USE AND POINT OF APPROPRIATION
 APPLICATION G-10617, PERMIT G-9982
 DESCHUTES COUNTY



TR 1412

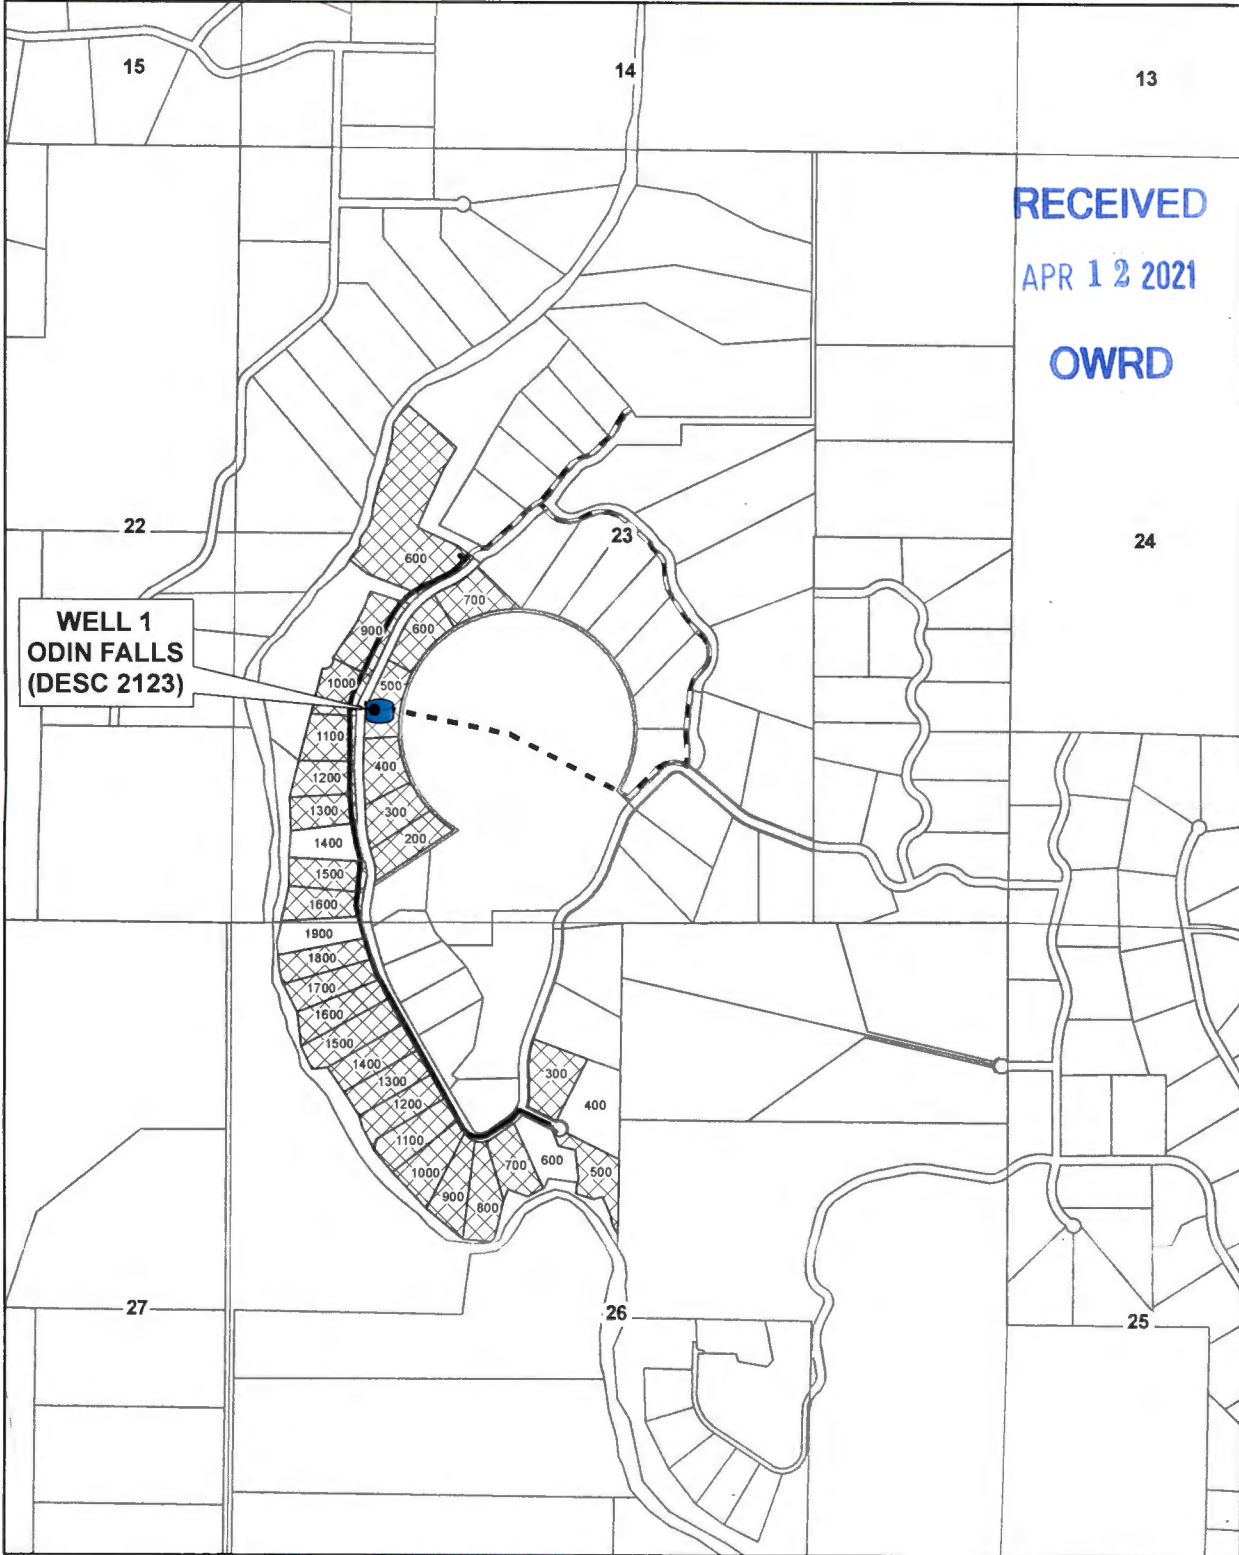


RECEIVED
APR 12 2021
OWRD

**WELL 1
 ODIN FALLS
 (DESC 2123)**

1 inch = 1,320 feet
 0 330 660 1,320 Feet

DRAWN BY: TANNER LEMMON
 AVION WATER GIS DEPARTMENT
 SEPTEMBER, 2020

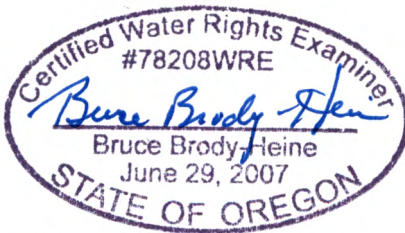

EXPIRES: 12-31-21

●	WELL	2-DOM	——
●	RESERVOIR	4-DOM	- - - -
▨	DEVELOPED LOTS (POU)	6-DOM	————
		8-DOM	——— ———

WELL 1 - ODIN FALLS
 NW 1/4, SW 1/4 of Section 23, T14S, R12E, WM - 1476' North and 1707' West from the S 1/4 corner Section 23; Lot 141223C000500: Hour meter located 10 feet to SE in equipment room

DISCLAIMER:
 This map was prepared for the purpose of identifying the location of water rights only and is not intended to provide legal dimensions or locations of property ownership lines.