


Claim of Beneficial Use for Permit S-54880 (Application S-85933) A Water Right in the Name of Howard and Judy Pope Trust

Polk County, Oregon


Township 9 South, Range 4 West (W.M.)

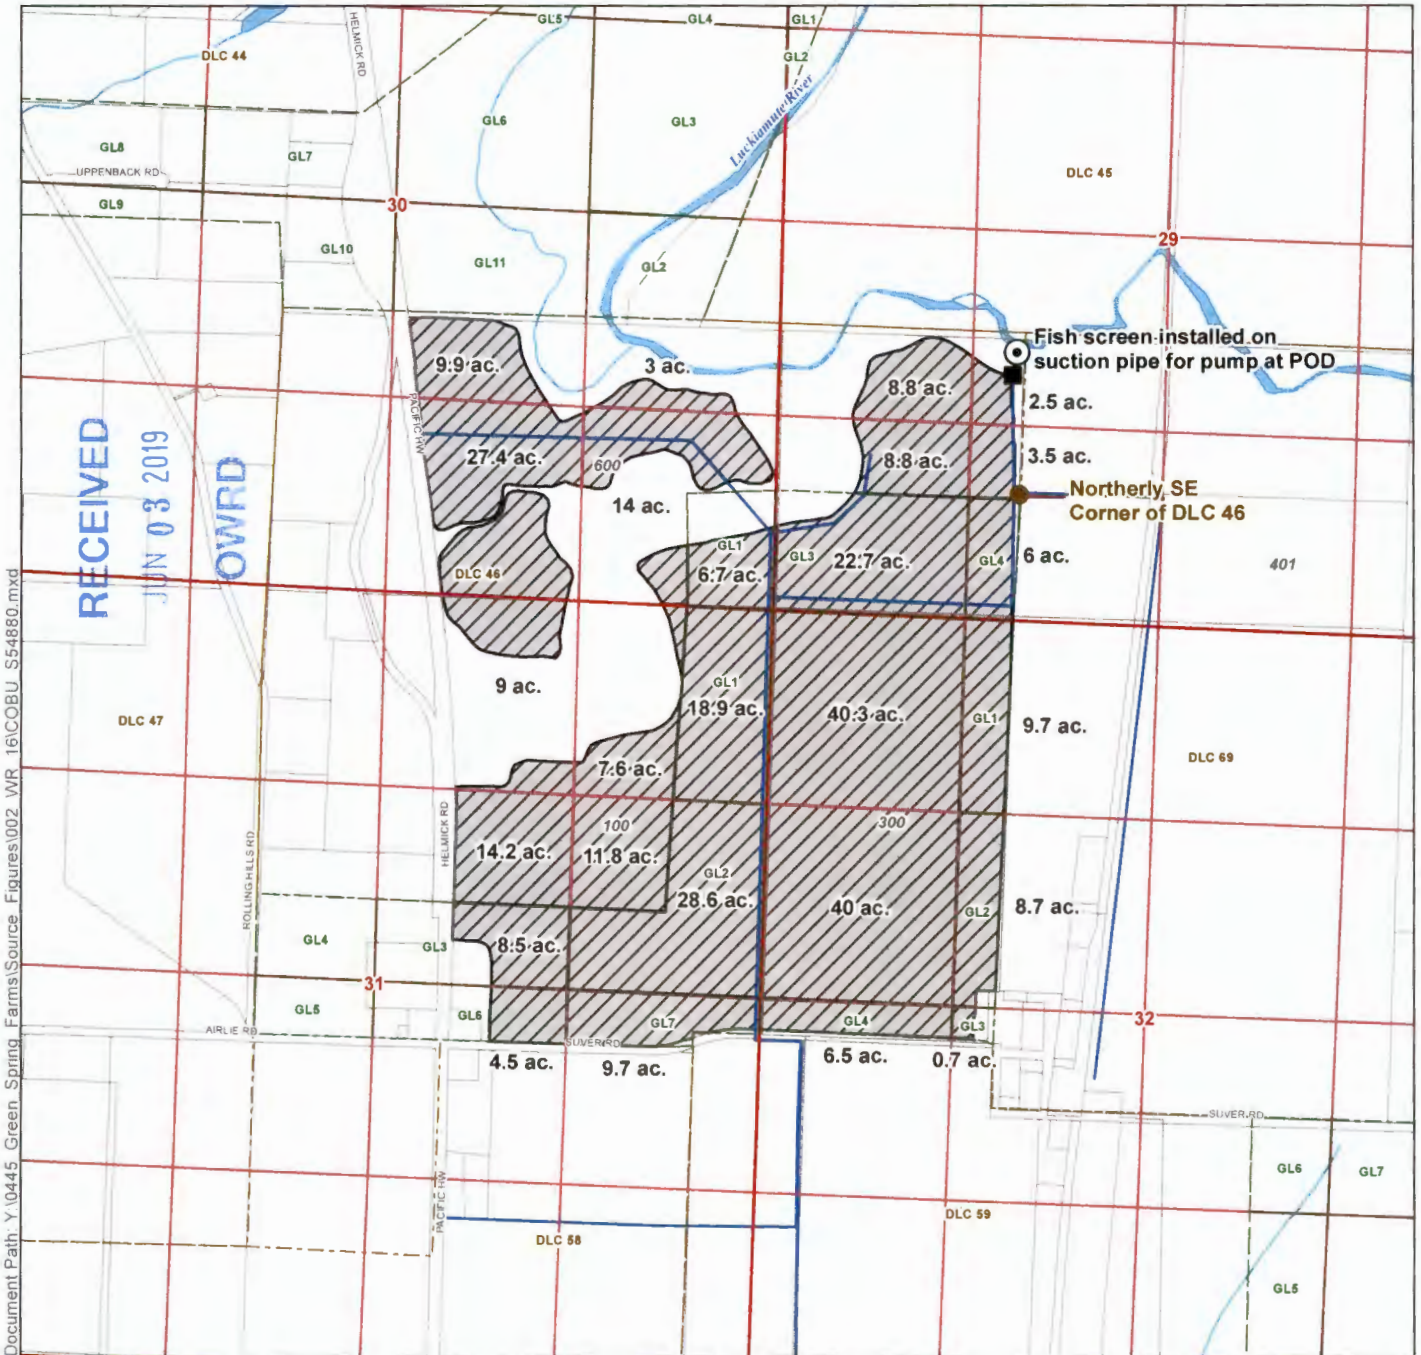

LEGEND

- Point of Diversion (POD)
- Flow Meter
- Mainline
- ▨ Place of Use (POU)
- Donation Land Claim (DLC)
- Government Lot (GL)
- All Other Features
 - Tax Lot
 - Watercourse
 - Waterbody

Certified Water Rights Examiner Stamp

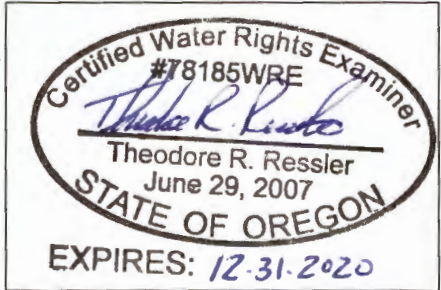

POD LOCATION DESCRIPTION

Point of Diversion
1,010 feet North and 58 feet West from Northerly SE Corner of DLC 46 (NESE), Township 9 South, Range 4 West (W.M.)

DISCLAIMER

This map was prepared for the purpose of identifying the location of a water right only and it is not intended to provide legal dimensions or location of property ownership lines.

MAP NOTES

Date: December 19, 2018
Data Sources: OWRD, Polk Co., Benton Co., BLM, USGS

