

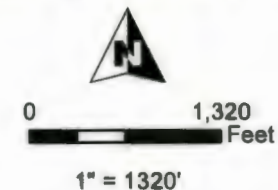


**T26S R33E, WM,
HARNEY COUNTY, OR**

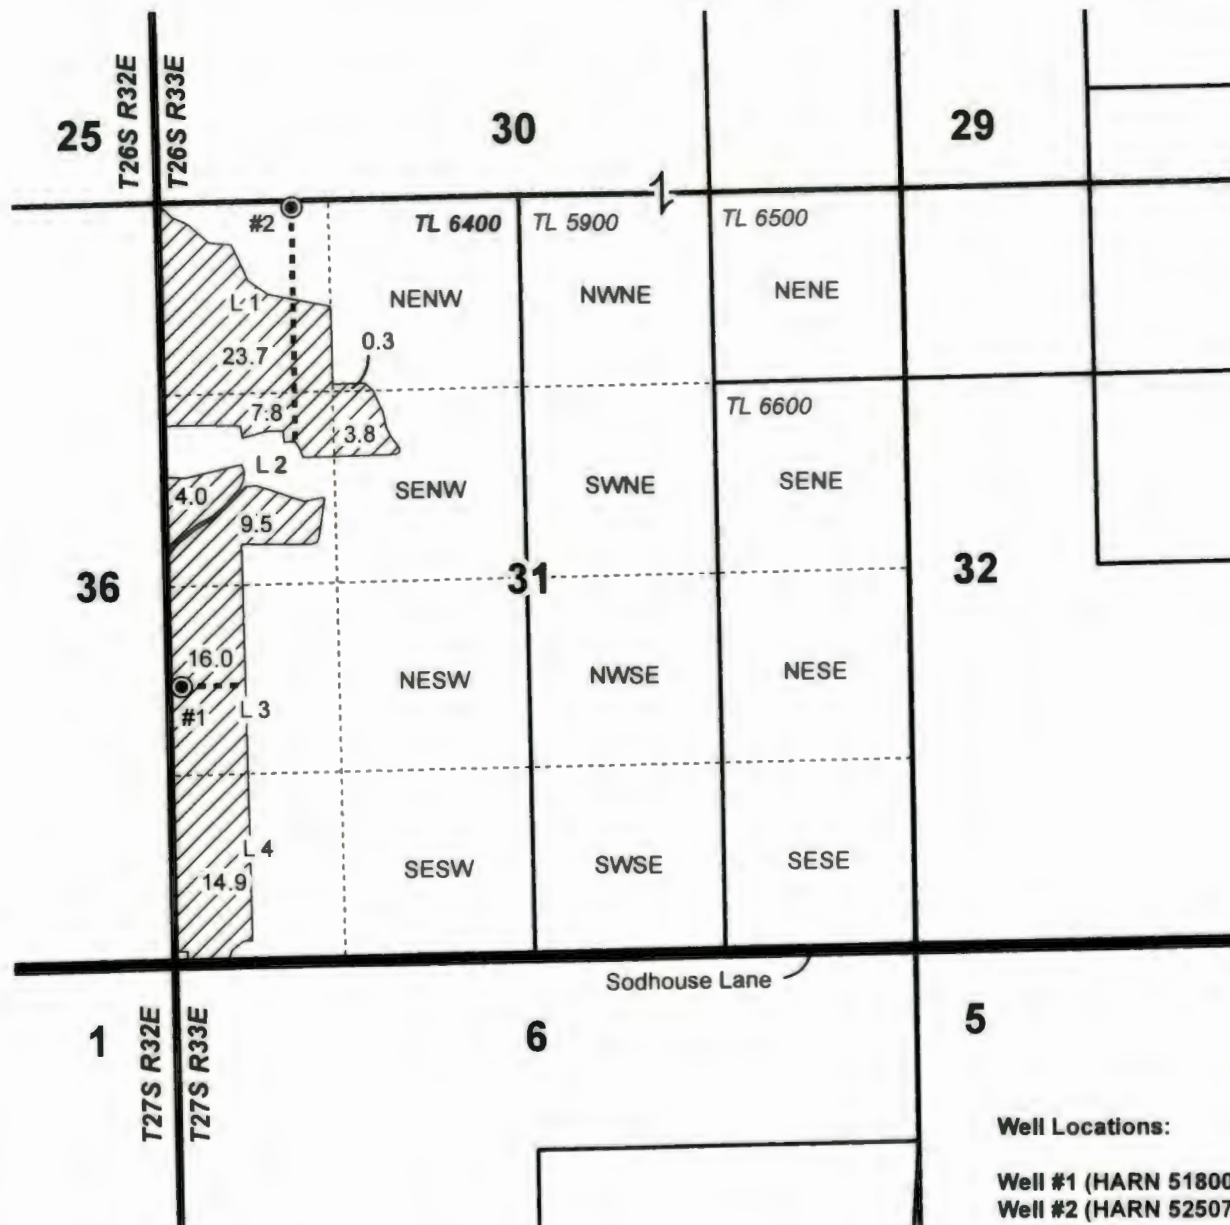

- Well & Meter
- Pipeline
- POU IR
- Township
- Section
- Quarter Quarter
- Tax Lot

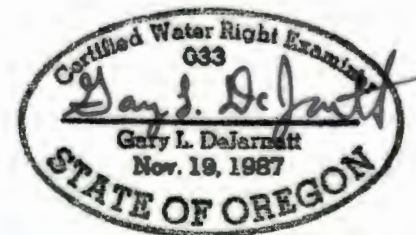

RENEWAL DATE 12/31/2021

Well Locations:

Well #1 (HARN 51800/L-102550): 1910' N, 50' E of SW Cor Sec 31
Well #2 (HARN 52507/L-119894): 30' S, 920' E of NW Cor Sec 31



**CLAIM OF BENEFICIAL USE MAP
Harney Spot Ranches, LLC**

Ap G-17511 Permit G-18113

Project #20040

Date: 10/8/2020

This map is not intended
to provide legal dimensions
or locations of property
ownership lines.

WATER RIGHT SERVICES, LLC

PO BOX 1830, BEND, OR 97709
WWW.OREGONWATER.US CCB # 197121
johnshort@usa.com 541-389-2837