


RECEIVED BY OWRID

DEC 27 2016

SALEM, OR

Claim of Beneficial Use Map under Permit S-54501
T 36 S, R 6 W, W M, Josephine County
Portions of Section 14
December 2, 2016

CERTIFIED WATER RIGHT EXAMINER
85312CWRE
Steve P. Boyd
STEVE BOYD
MAY 10, 2012
STATE OF OREGON
EXPIRES: 12/31/2017

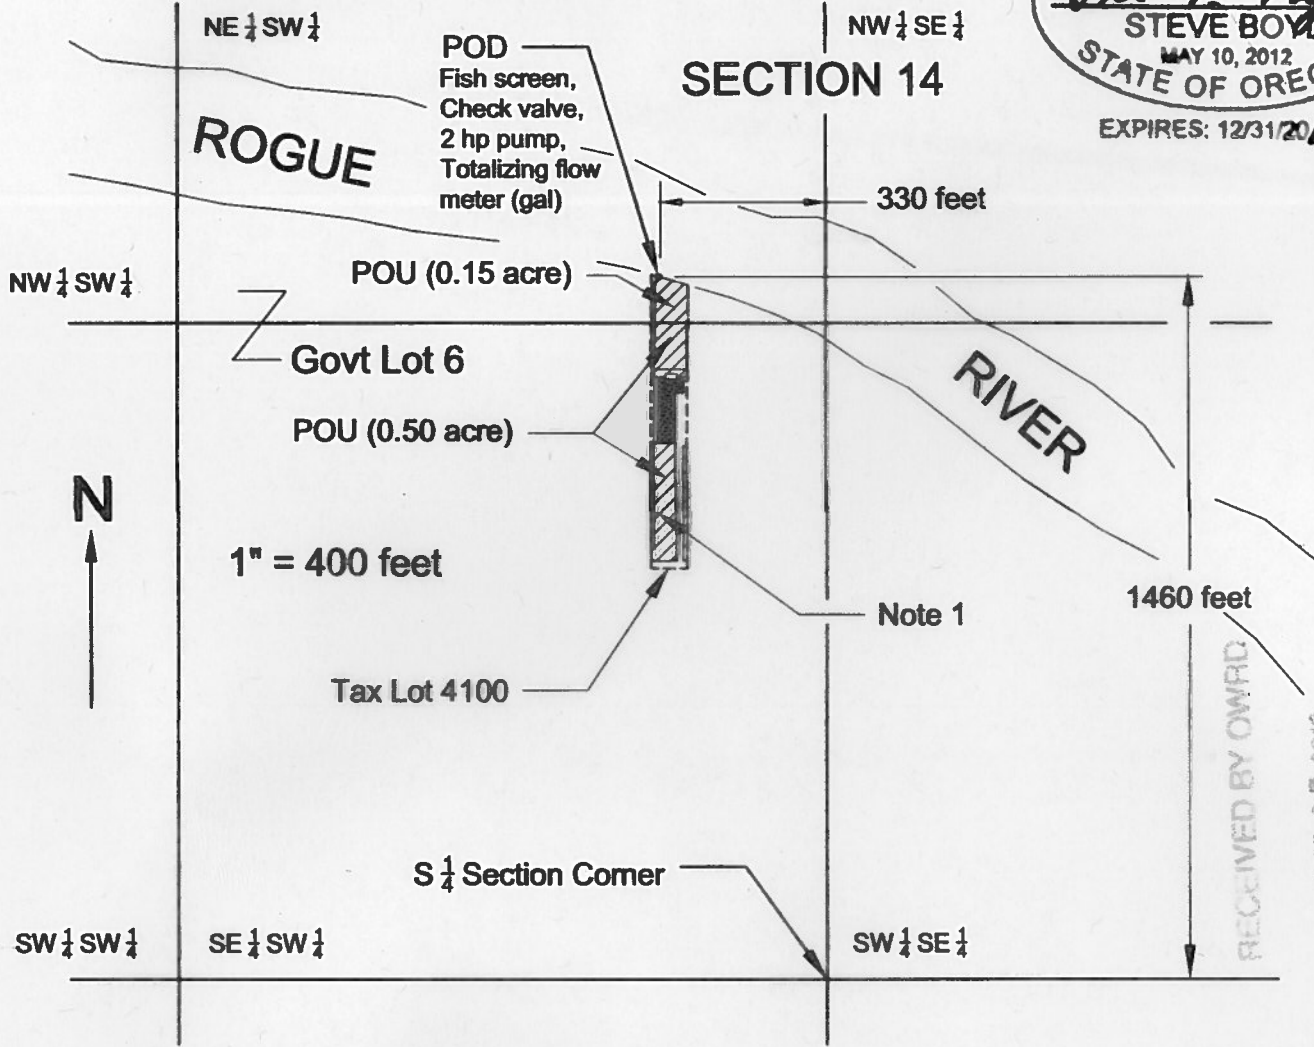

0.65 acre irrigated under Application File No. S-87225 and Permit S-54501 with Date of Priority July 14, 2008.

POD

Point of Diversion (POD) is 1,460 feet N & 330 feet W of South 1/4 Section Corner of Section 14.



Structures

Note 1

2.0 inch dia. buried PVC pipe feeding sprinklers providing irrigation to lawn and fruit trees.

This map was drawn by Steven P. Boyd (CWRE# 85312) for Kathleen Snell (owner of Tax Lot 4100) to support her Claim or Beneficial Use for irrigation.

NOTE: This map is not intended to provide legal dimensions or locations of property ownership lines.

RECEIVED BY OWRID

DEC 27 2016

SALEM, OR