


Claim of Beneficial Use
Permit G-17843 Application G-17255
In the name of Connie Hines

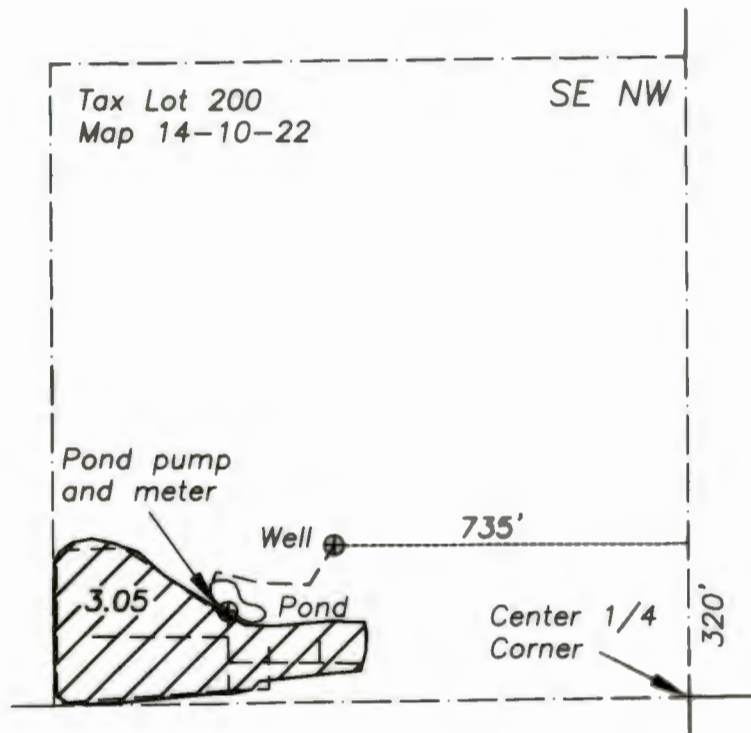

Section 22
T14S R10E WM
Deschutes Co. Oregon



This map is for the purpose of identifying the location of the water right. It is not intended to provide legal dimensions or locations of property ownership lines.



Point of Appropriation

320' North and 735' West from the Center 1/4 of Section 22



Beneficial use under Permit G-17843
(Priority date 8/21/2009)



Tax lot boundary



Buried mainline



Well and meter



1/16 Section lines

RECEIVED

OCT 09 2018

OWRD