

CLAIM OF BENEFICIAL USE MAP

APP. # S-73263 PERMIT #S-51855, TAX LOT 400 COOS COUNTY,
LOCATED IN SECTION 25 OF TOWNSHIP 29 SOUTH, RANGE 15 WEST, W.M.



ALL DISTANCES FROM EAST 1/4 CORNER SECTION 25

DAN'S RES#1	1444' NORTH
	477' WEST
DAN'S RES#2	1134' NORTH
	562' WEST
P.O.D.	1405' NORTH
	558' WEST

P.O.U
PER Q.Q. SECTION 25

Q.Q.	ACRES
SE NE	2.3
NE NE	0.5
TOTAL	2.8

RECEIVED

OCT 26 2016


OWRD

LEGEND

- STAFF GAUGE
- PUMP WITH TOTALIZING FLOWMETER DOWNSTREAM
- MAINLINE PIPE
- CRANBERRY BOG
- RESERVOIR
- STREAM/CREEK



EXPIRES 12/31/19

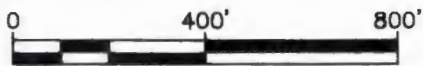

DISCLAIMER: THIS MAP WAS PREPARED FOR THE PURPOSE OF IDENTIFYING THE LOCATION OF WATER RIGHT ONLY AND IS NOT INTENDED TO PROVIDE LEGAL DESCRIPTIONS OR LOCATIONS OF PROPERTY LINES



705 S. 4TH ST. PHONE: (541) 267-2872
P.O. BOX 116 FAX: (541) 267-0588
COOS BAY, OREGON 97420 www.stuntzner.com
Engineering - Land Surveying - Forestry - Land Planning - Water Rights

JOB #: 117-165	PREPARED FOR:	CHARLES O'DONNELL
DATE: SEP 7, 2016		93141 FLORAS LAKE DR
DRAWN BY: ABM		LANGLOIS, OR 97450
CHECKED BY: MVC	FILE NAME: 117-165 COBU_ABM.dwg	SHEET 1 OF 1