


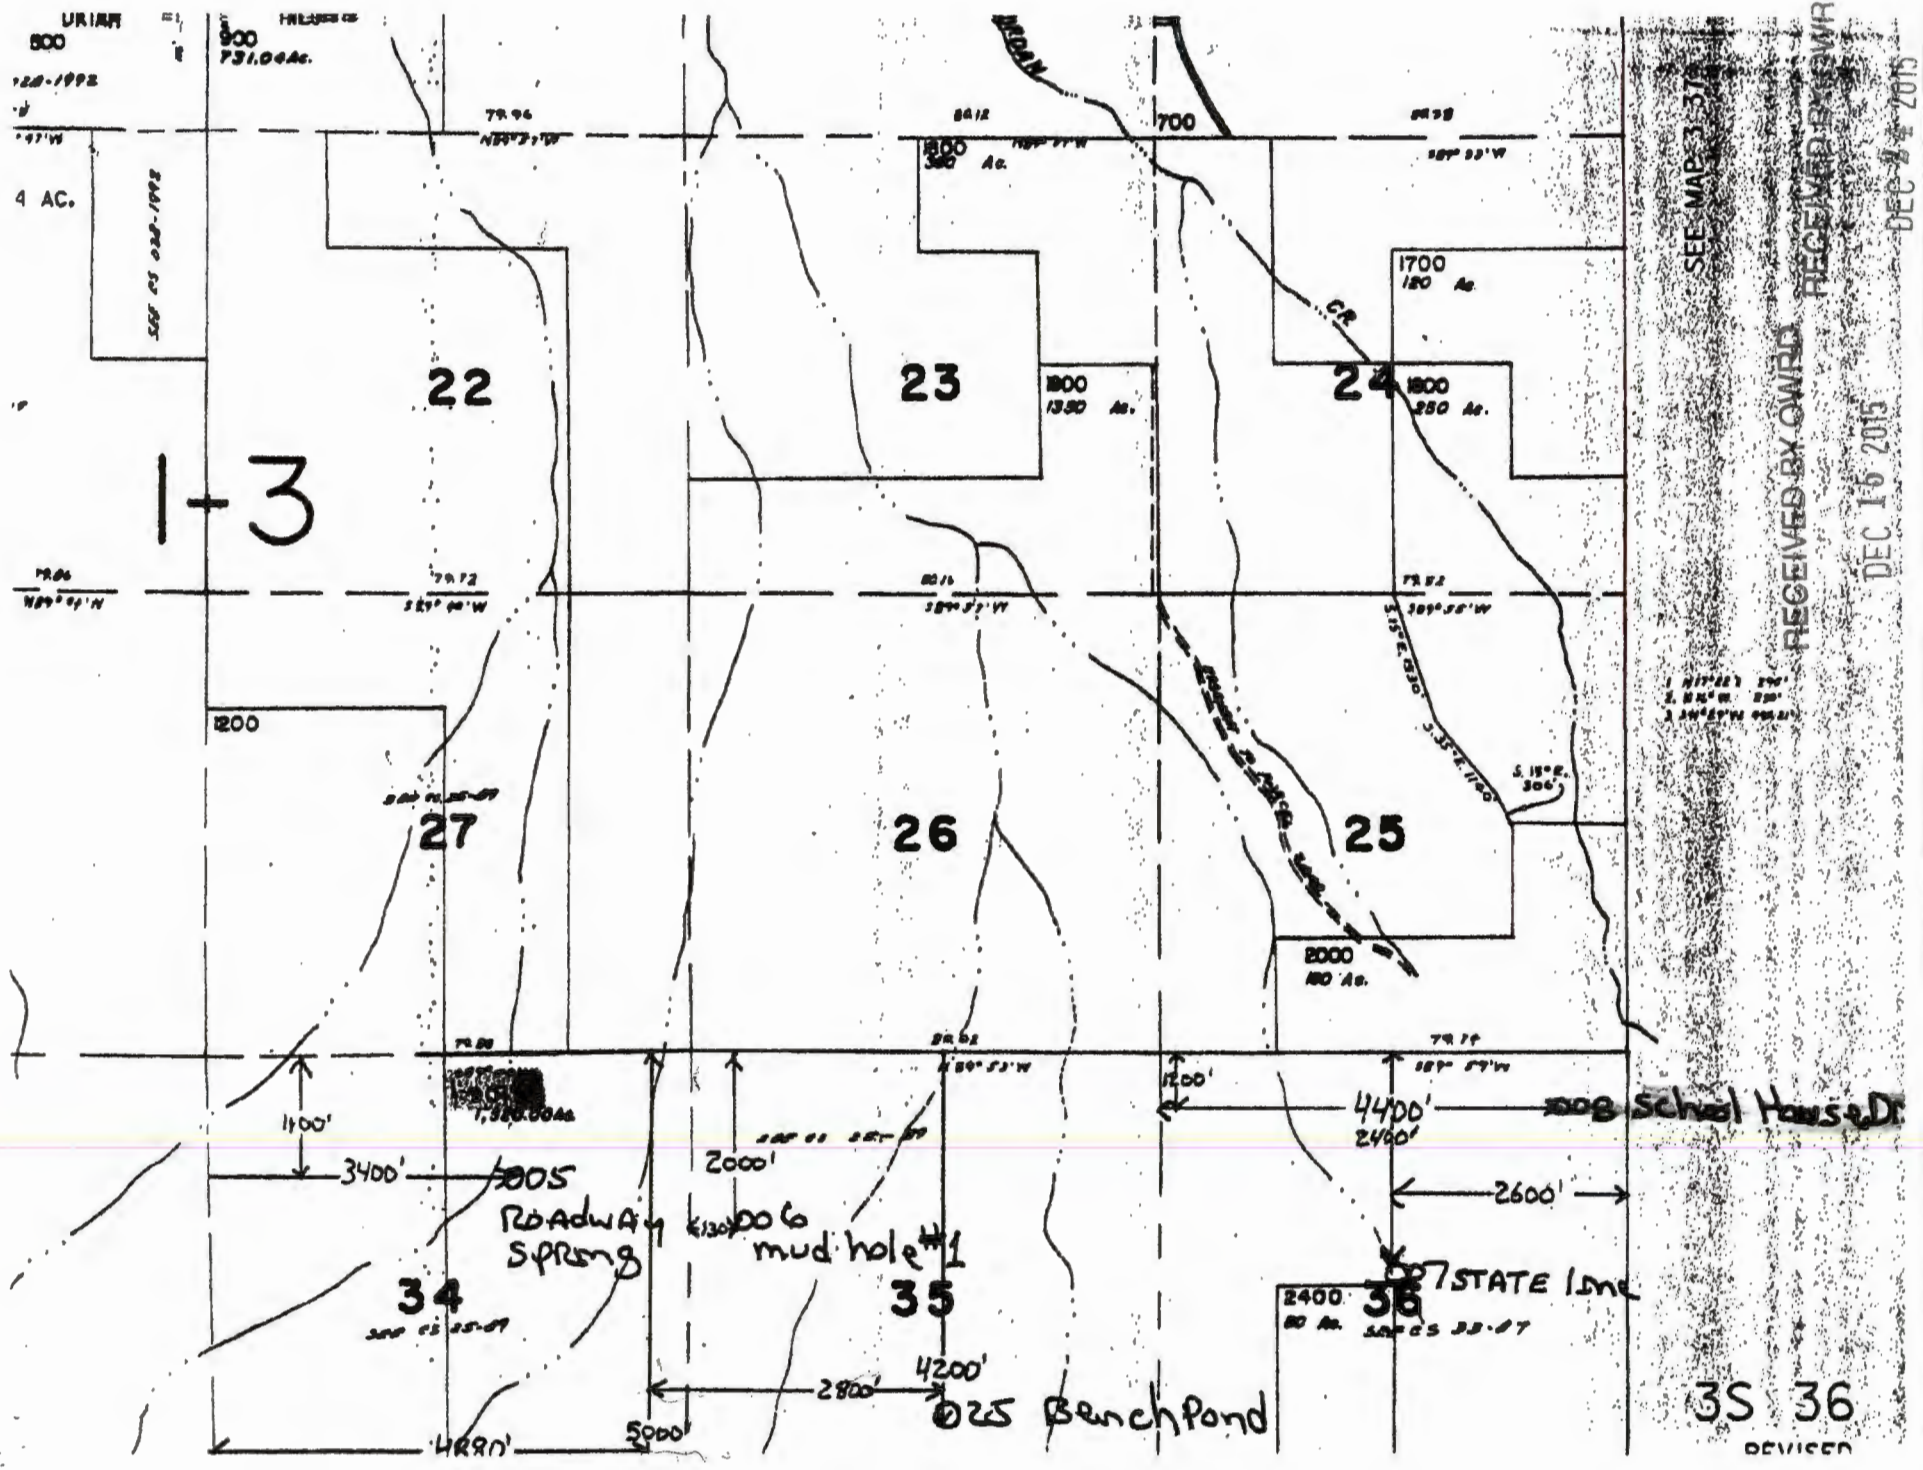

SEE MAP 3-37
RECEIVED BY OWRD
RECEIVED BY OWRD
DEC 16 2015
DEC 16 2015

SALEM, OR

SALEM, OR

Lower Haywire near bridge