


T.4S. R.36E W.M.
UNION COUNTY

Application No. R-850#33
Permit No. R-133#58

4S 36

1" = 2000'

CANCELLED NO.
600

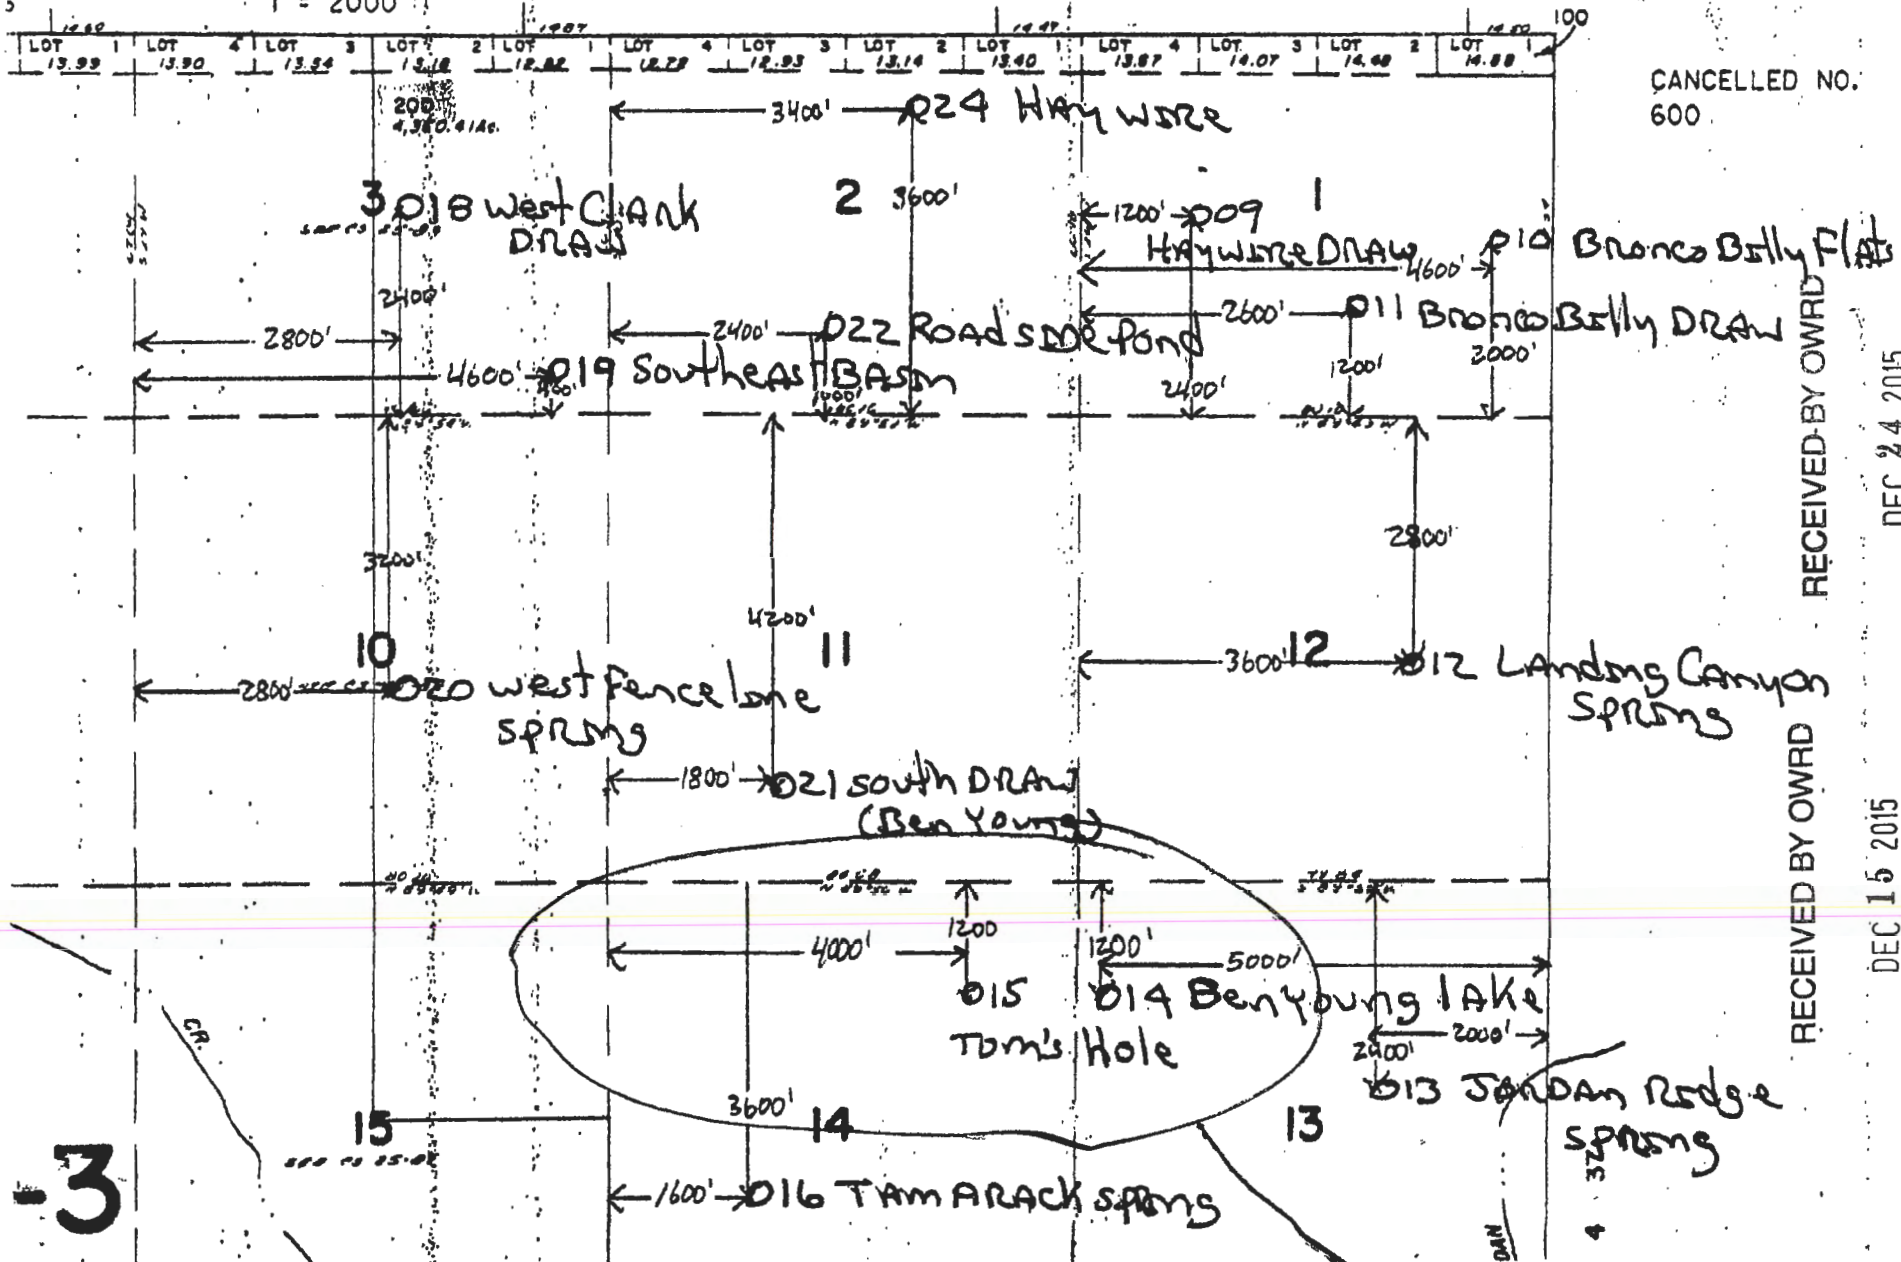

RECEIVED BY OWRD

DEC 24 2015

SALEM, OR

RECEIVED BY OWRD

DEC 15 2015

SALEM, OR

-3