

T.4S. R.36E W.M.
UNION COUNTY

Application No. R-850133
Permit No. R-13358

4S 36

1" = 2000'

CANCELLED NO.
600

RECEIVED BY OWRD


DEC 24 2015

SALEM, OR

RECEIVED BY OWRD

DEC 15 2015

SALEM, OR

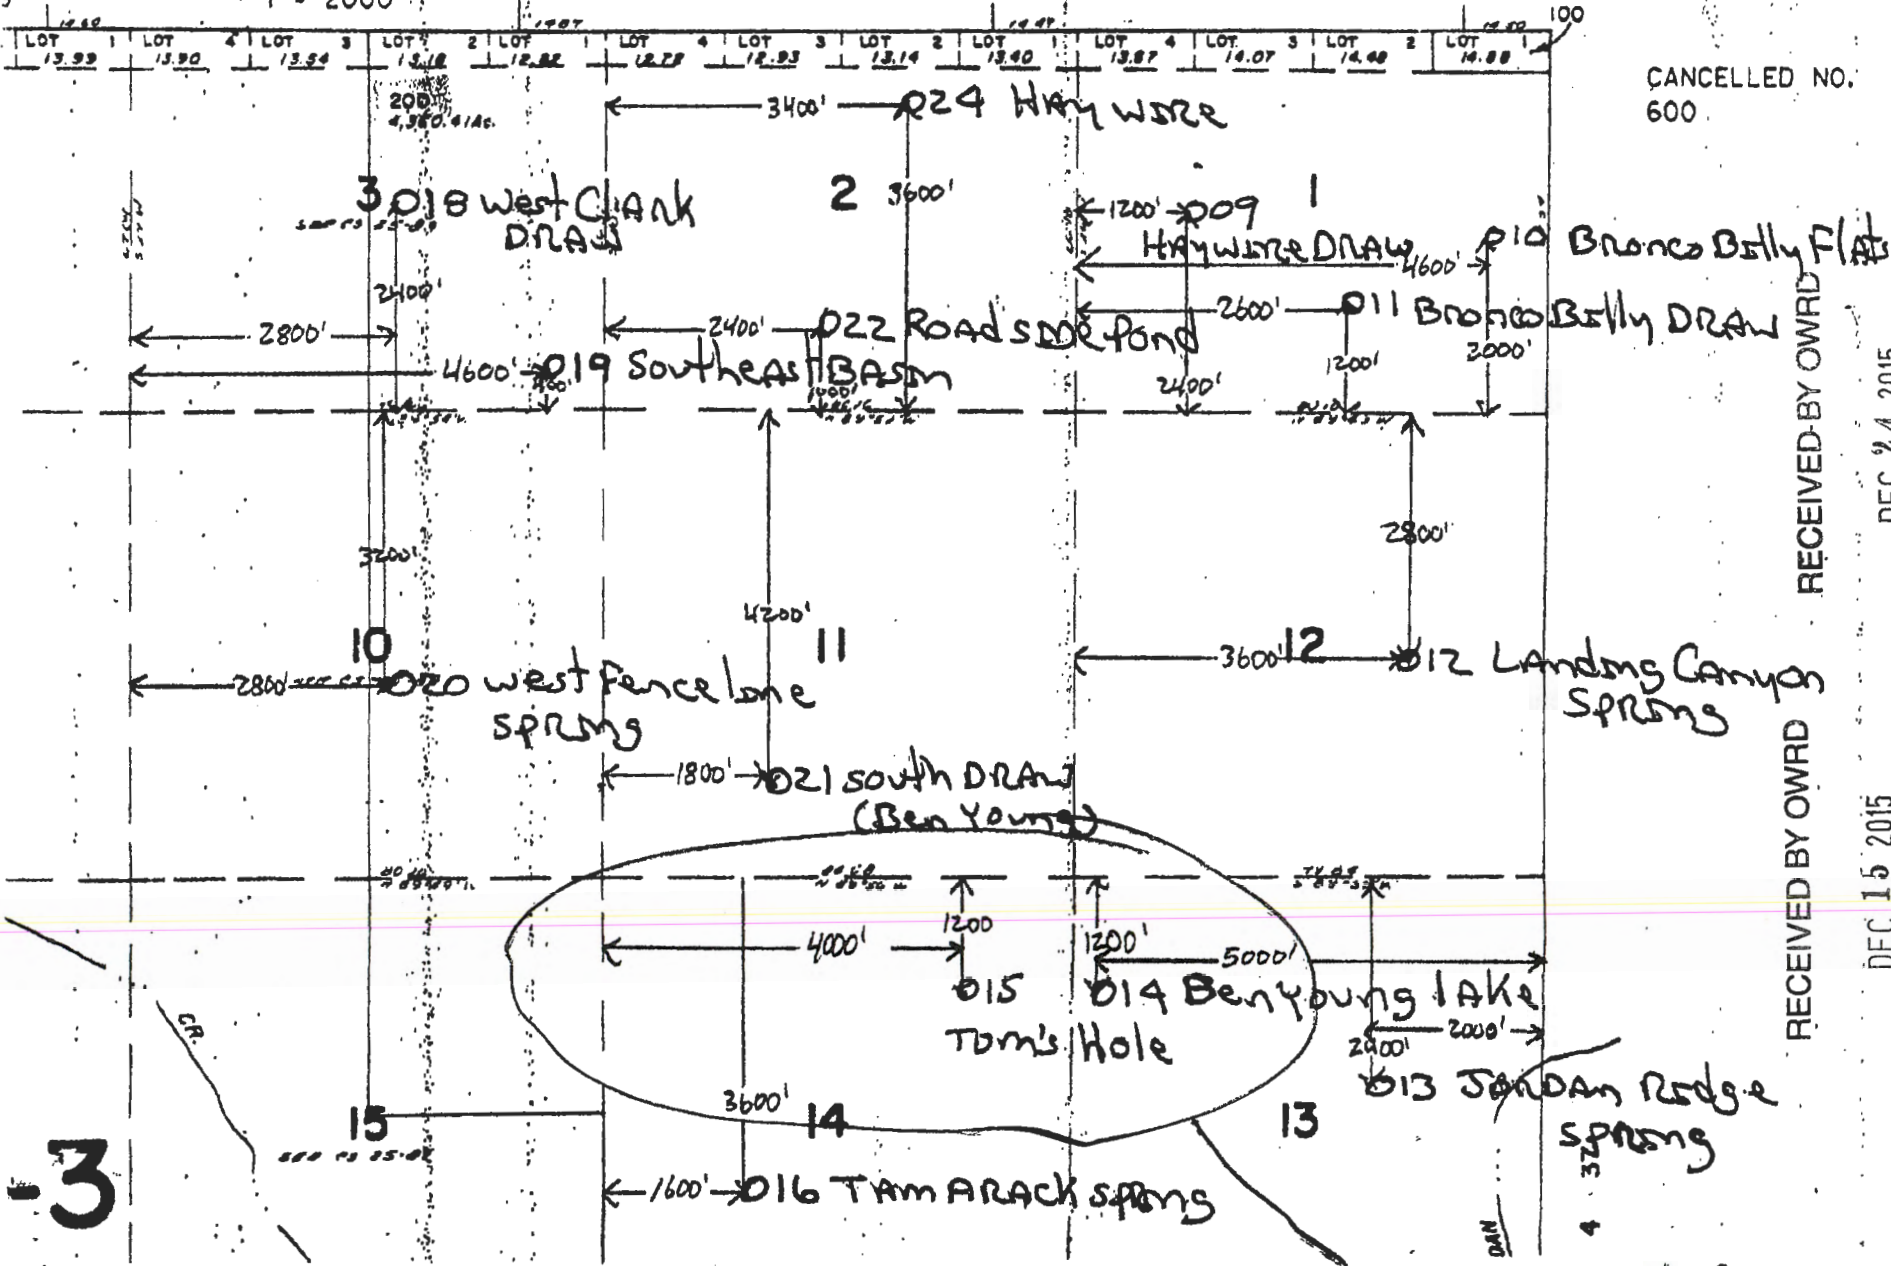

-3

1915 Tom's Hole