


T.4S. R.36E W.M.
UNION COUNTY

Application No. R-850314
Permit No. R-133589

4S 36

1" = 2000'

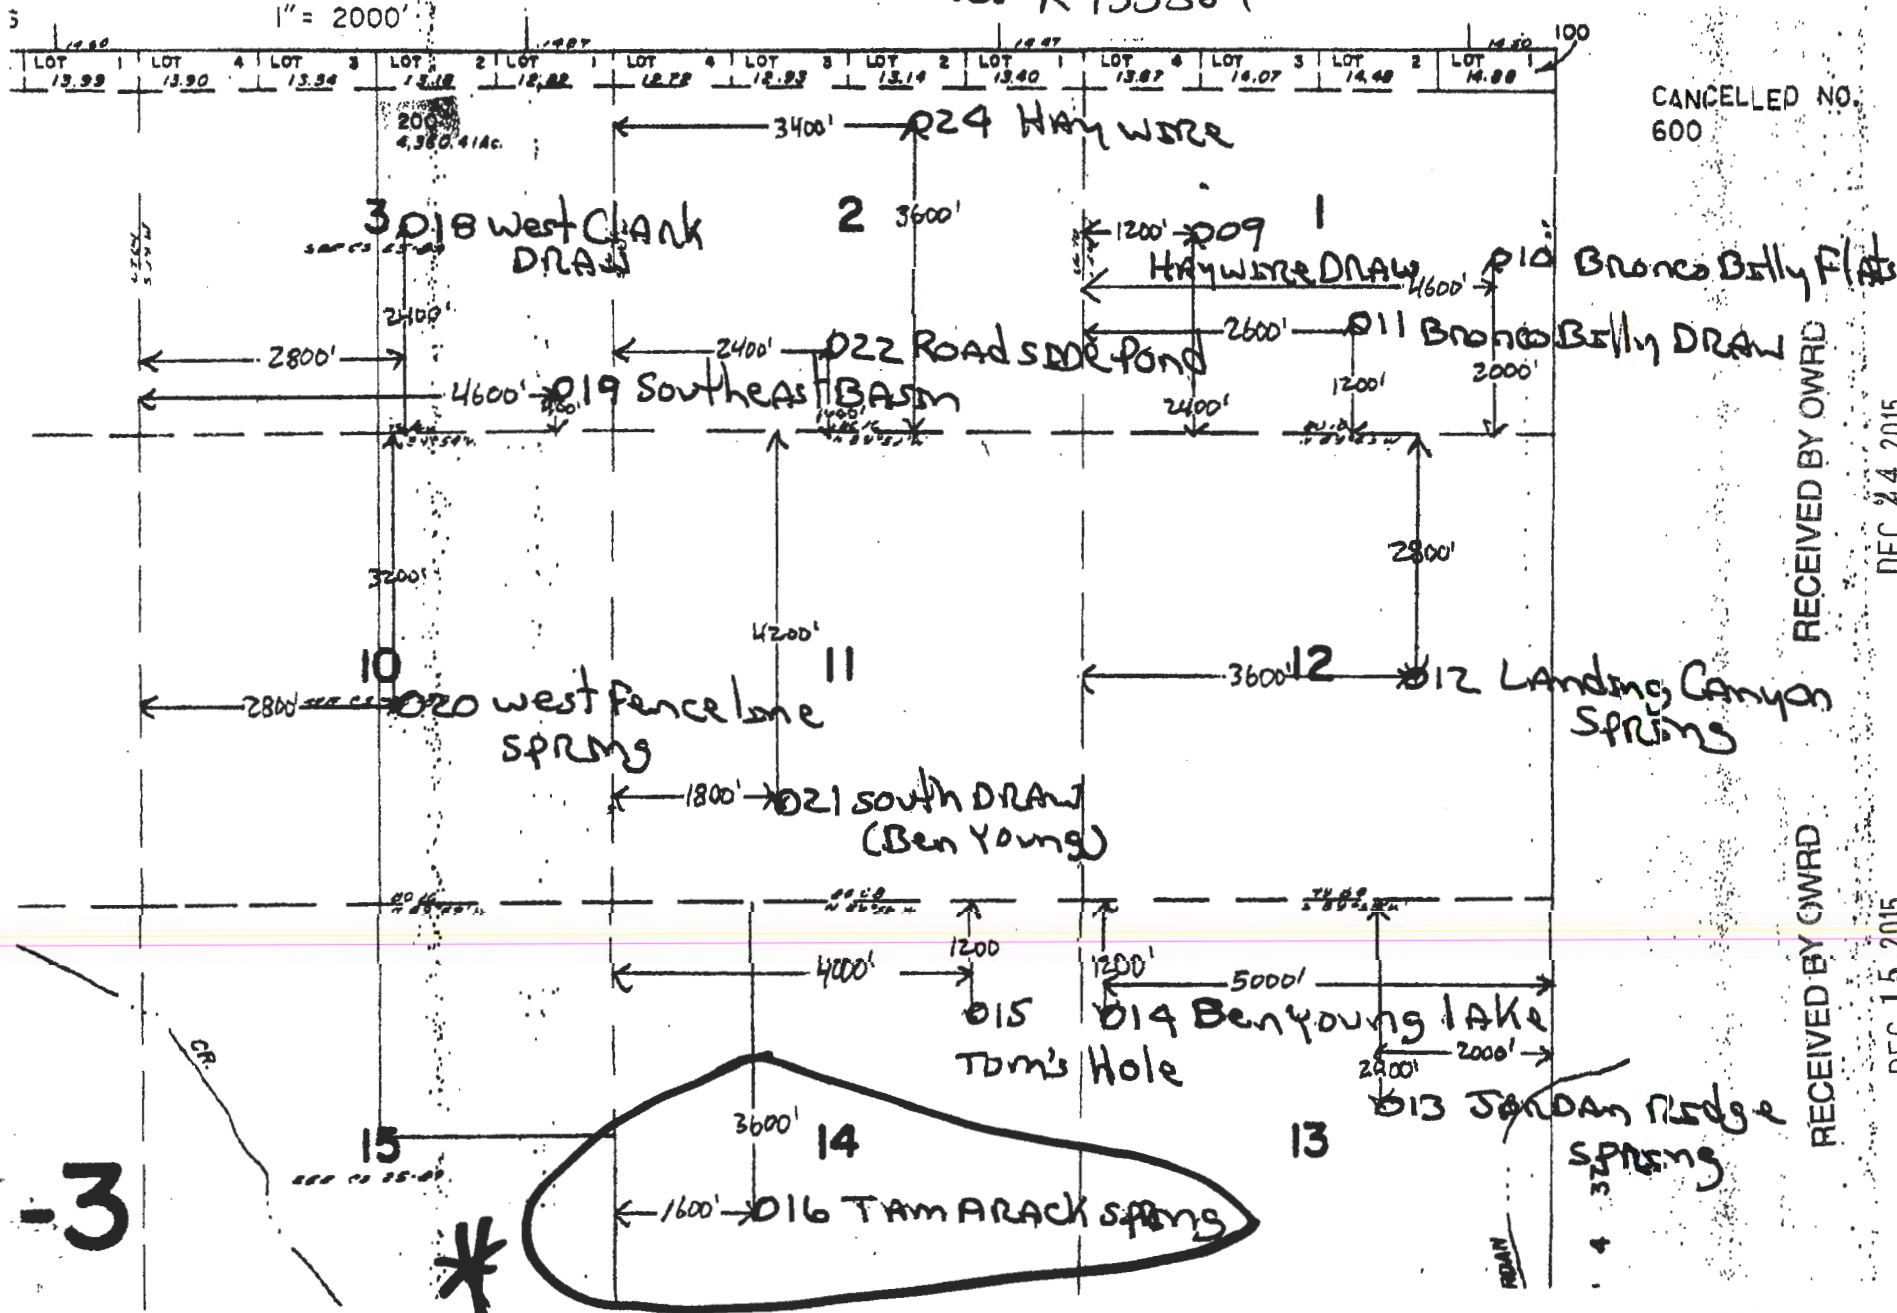

CANCELLED NO.
600

RECEIVED BY OWRD

DEC 24 2015

SALEM, OR

RECEIVED BY OWRD

DEC 15 2015

SALEM, OR

-3