

Claim of Beneficial Use




Application No. G-14967

Permit No. G-15703


RECEIVED BY OWRD

DEC 21 2017

SALEM, OR

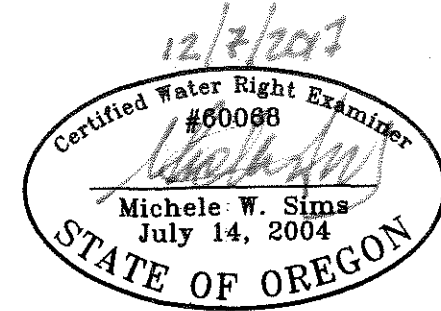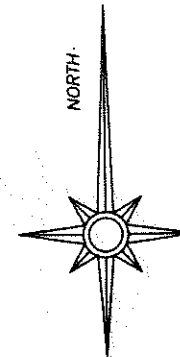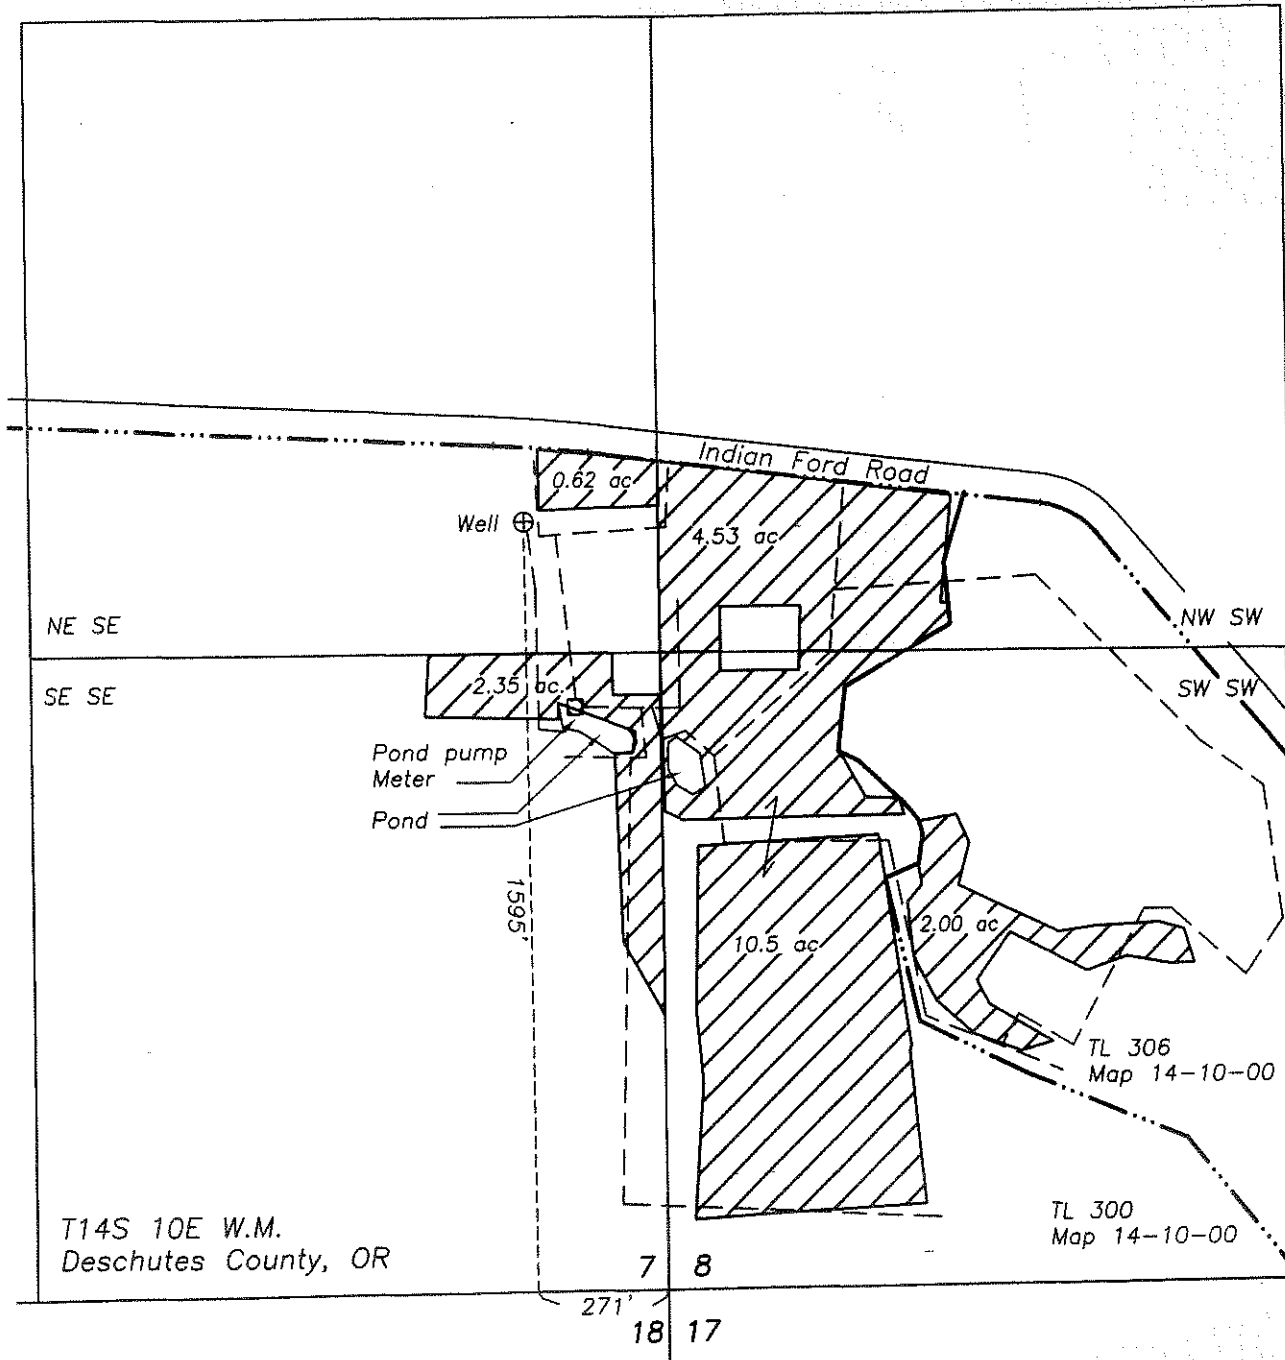

Renewal date: 6/30/2018

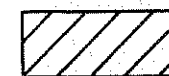

Water applied under Permit G-15703
(Priority date 4/9/1999)



Tax lot boundary



Buried mainline



Well



1/16 Section lines



GRAPHIC SCALE - FEET

This map is for the purpose of identifying the location of the water right. It is not intended to provide legal dimensions or locations of property ownership lines.

Michele W. Sims, Consultant, LLC

Sisters, Oregon 97759 541-408-4777