


FINAL PROOF SURVEY


T 6 S R 2 W WM.

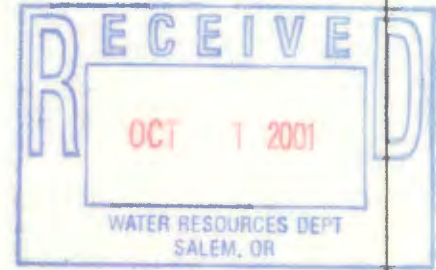

SE $\frac{1}{4}$ SW $\frac{1}{4}$ and SW $\frac{1}{4}$ SE $\frac{1}{4}$ SECTION 9


application # G-13108 permit # G-11717

For: Terry Silbernagel

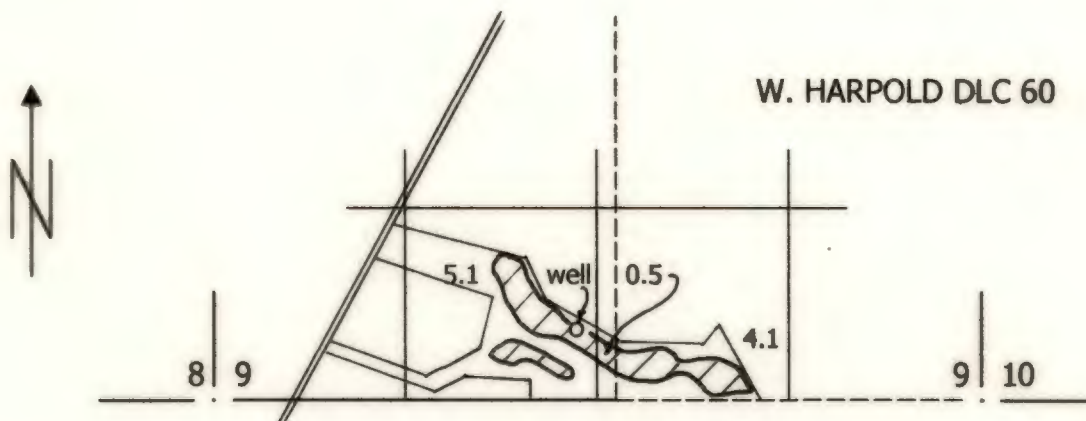

diversion point location: N $78^{\circ} 45'$ E, 2550' from the SW corner section 9

Scale 1" = 1320'

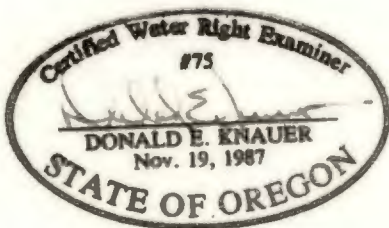

This map is to be used for water right purposes only.

Don Knauer Consulting
PO Box 5416
Salem, OR 97304
503-585-8474