



**LEGEND**

- PVC Pipeline Buried (Installed)
- Gold Crest Irrigation Ditch (Removed)
- Galls Creek
- Place of Use - Conserved Water 5.6 Acres Cert. 16212
- Place of Use - Transfer 12927
- Taxlot
- Quarter Quarter

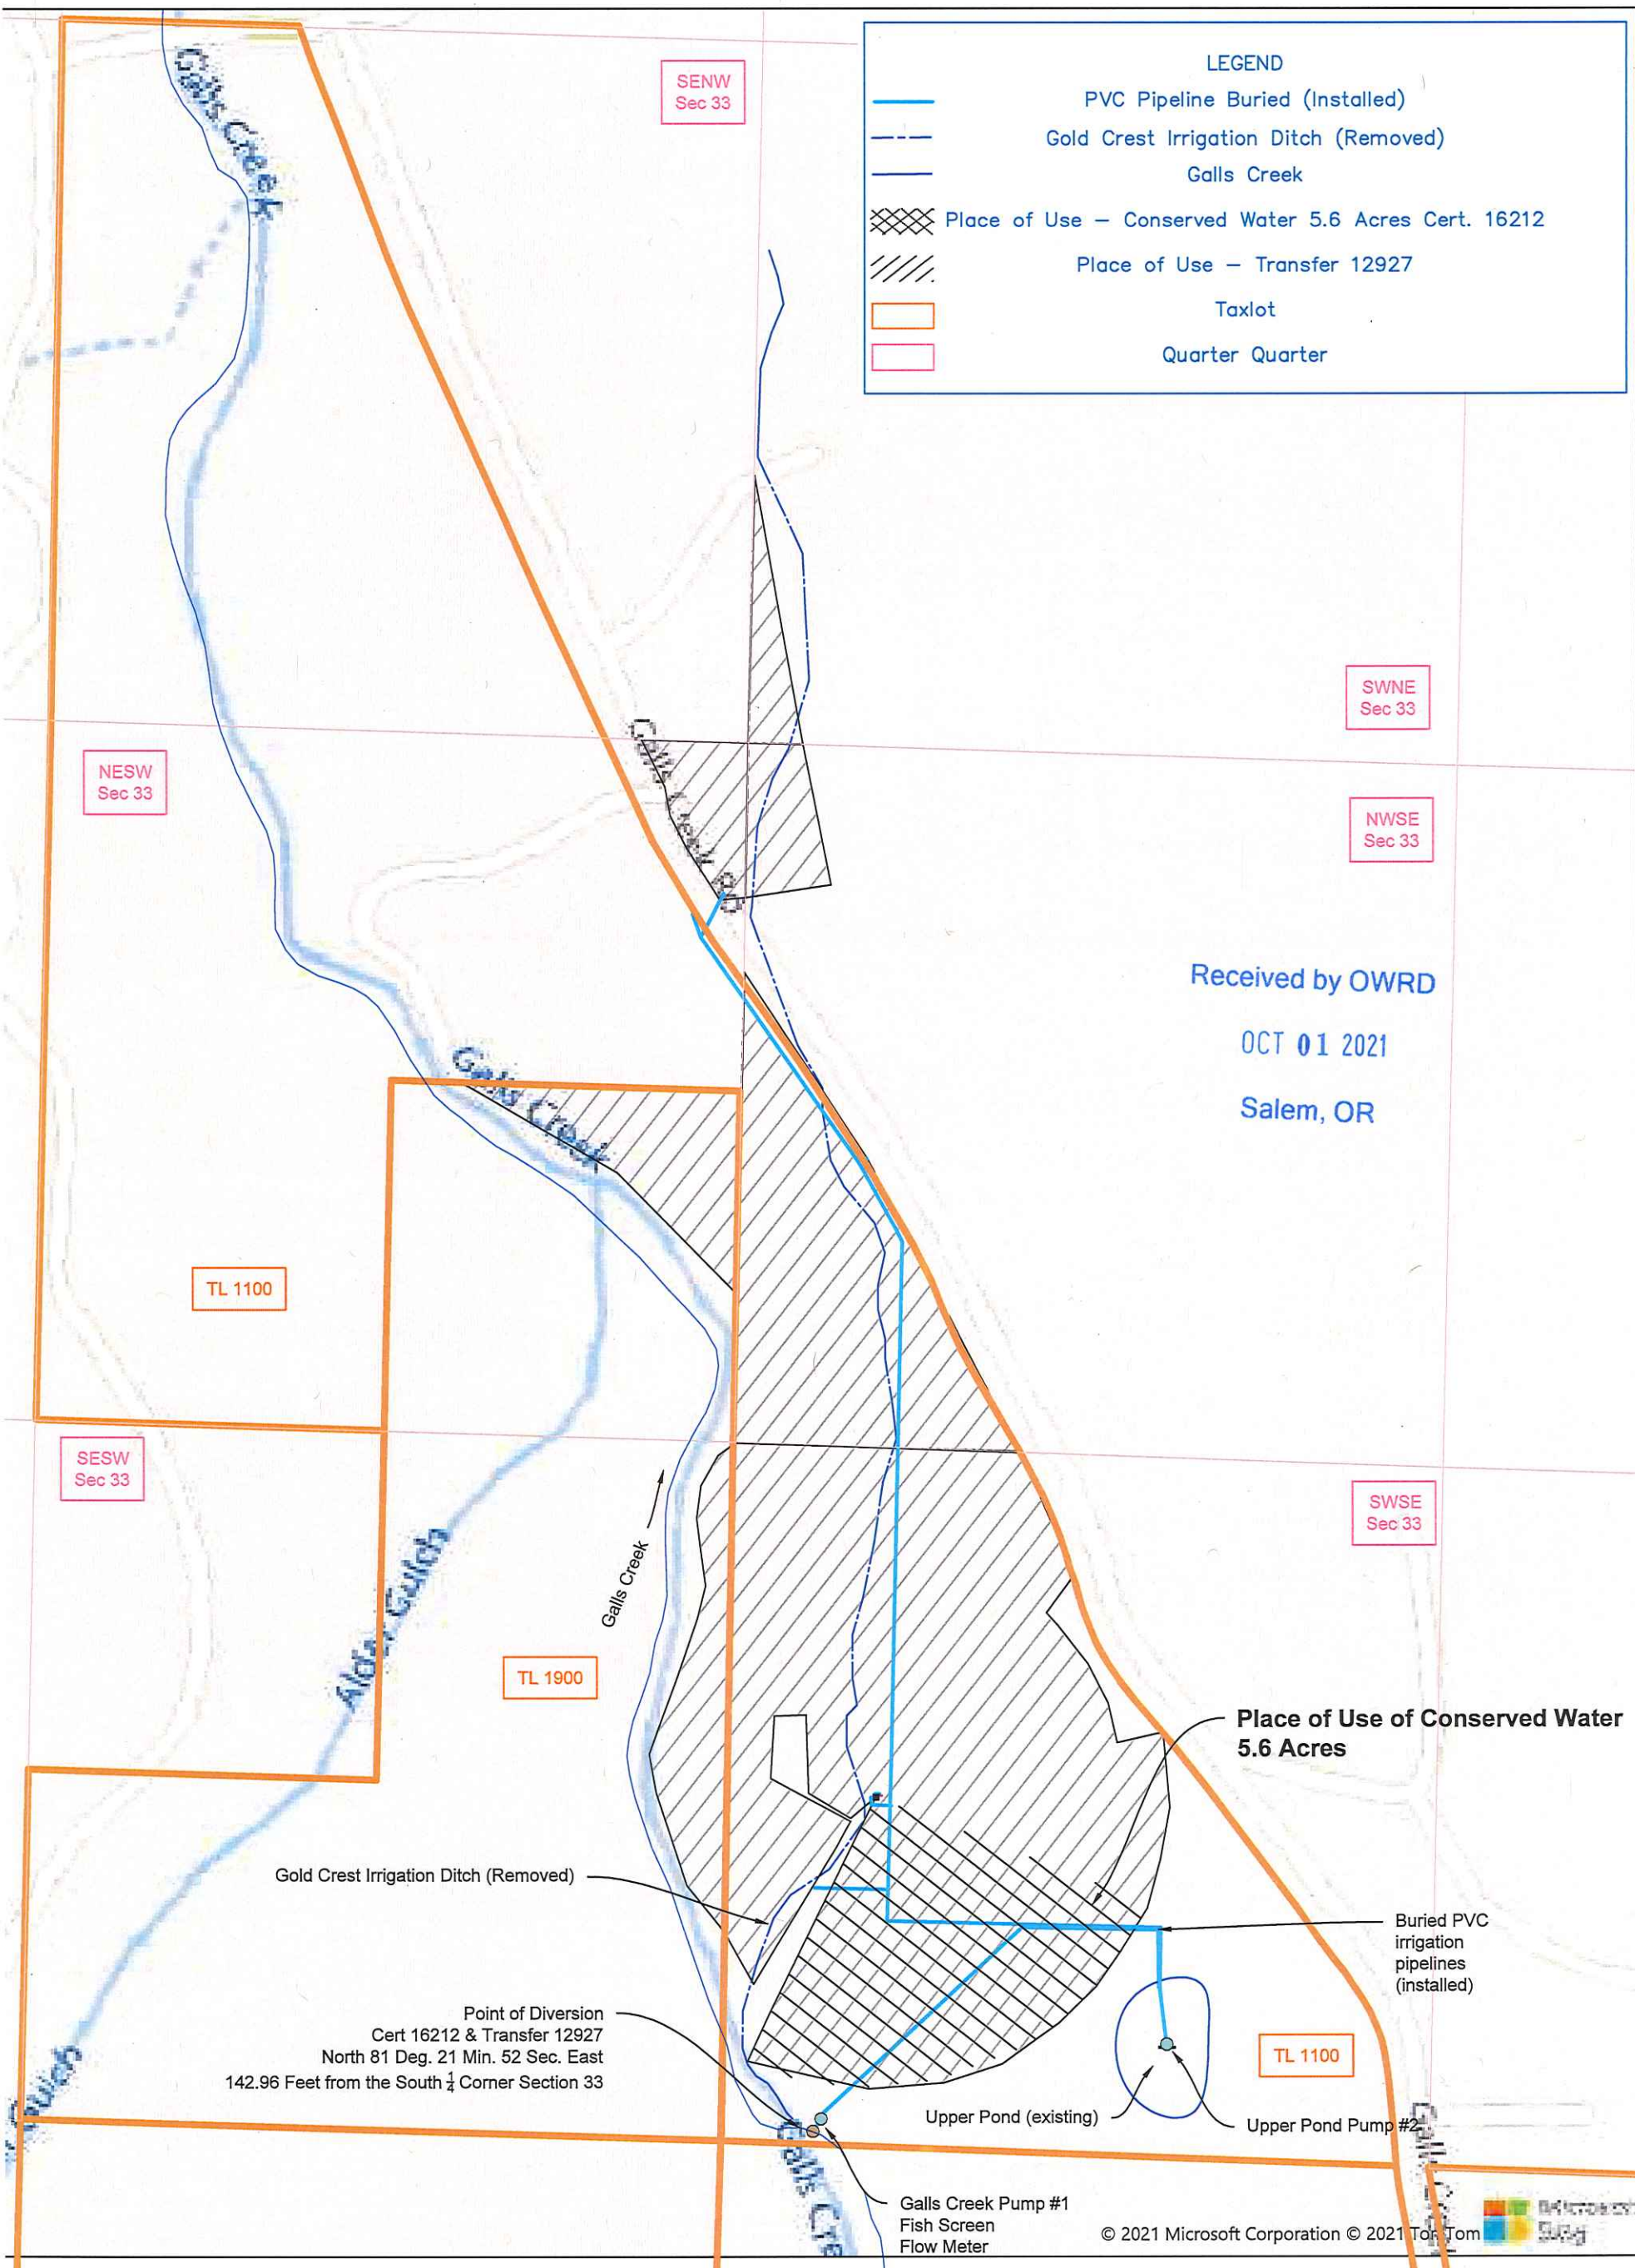

**PLAN VIEW**

300 0 300  
Scale in feet

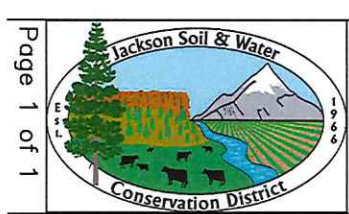

GALLS CREEK IRRIGATION CONVERSION PROJECT  
 REQUEST FOR FINALIZATION MAP for CW-120  
 2672 Galls Creek Road, Gold Hill, OR 97525  
 SECTION 33, T.36S., R.3W., W.M.  
 JACKSON COUNTY OREGON

	Date
Designed By:	Hydro-Flow Inc./JW Kerns/PD 2020
Drawn By:	PD 9/28/2021
Checked By:	PD 9/28/2021
Approved By:	_____
Title:	SWCE