

CLAIM OF BENEFICIAL USE

APPLICATION R-83997


PERMIT R-12751

APPLICATION S-83998

PERMIT S-53629

TOWNSHIP 29 SOUTH, RANGE 15 WEST, W.M.

COOS COUNTY OREGON

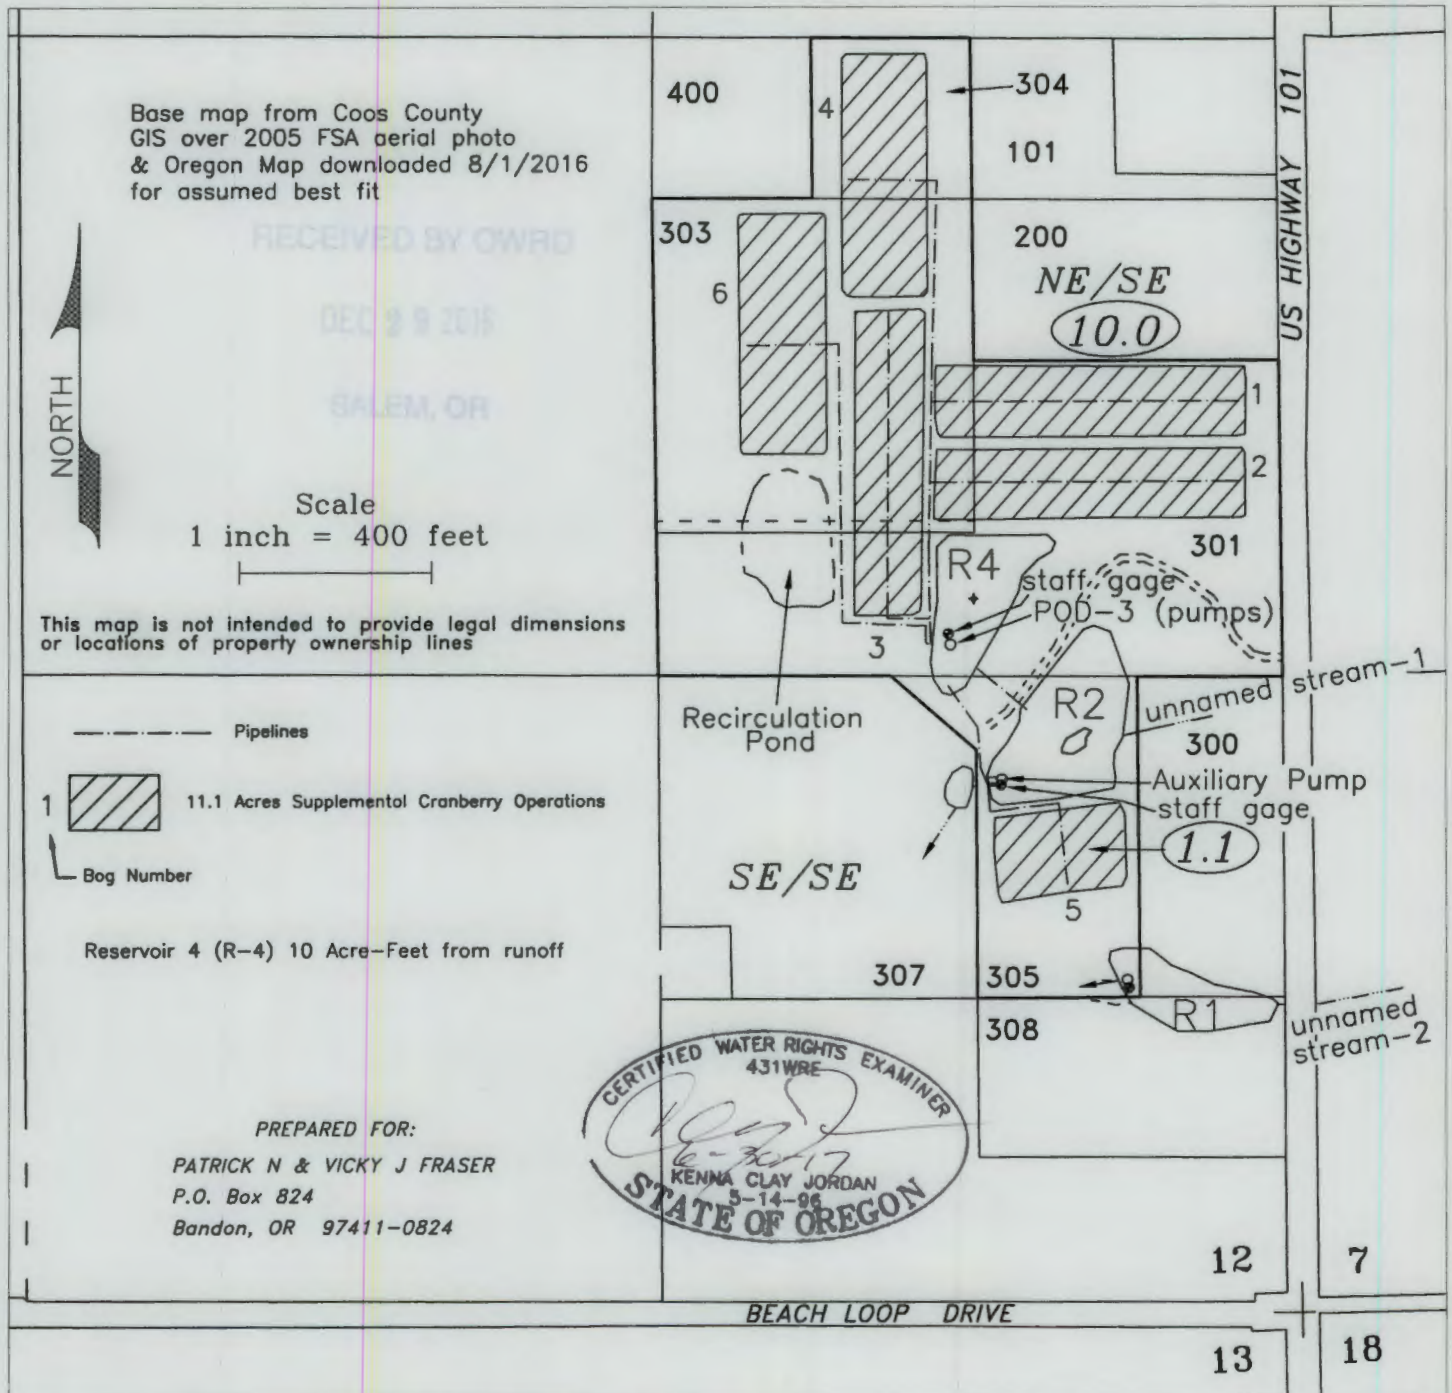

POINTS OF DIVERSION (All from the SE Corner of Section 12)

Reservoir 4 center - NE/SE, 1485 ft. North & 680 ft. West (drains to Reservoir 2 for distribution to bog 5 from POD-2)

POD-3 (Reservoir 4) NE/SE, 1390 ft. N & 730 ft. West - POD-3 delivers water to bogs 1, 2, 3, 4, 6

Auxiliary pump in R-2 (bulge) delivers water to bog 5 (12" CPP from R-4 to R-2)

JORDAN ENGINEERING
460 JORDAN LANE
ROSEBURG, OR 97471
(541) 673-1931

5/6/2010 n.e.d.
Revised 9/19/2016 n.e.d.