

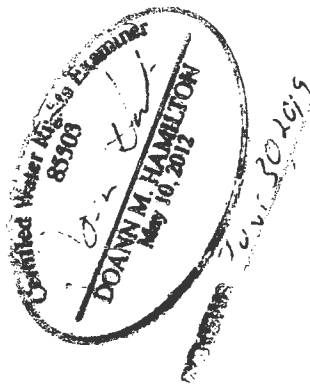


T.6S. R.1E. Section 30, W.M.

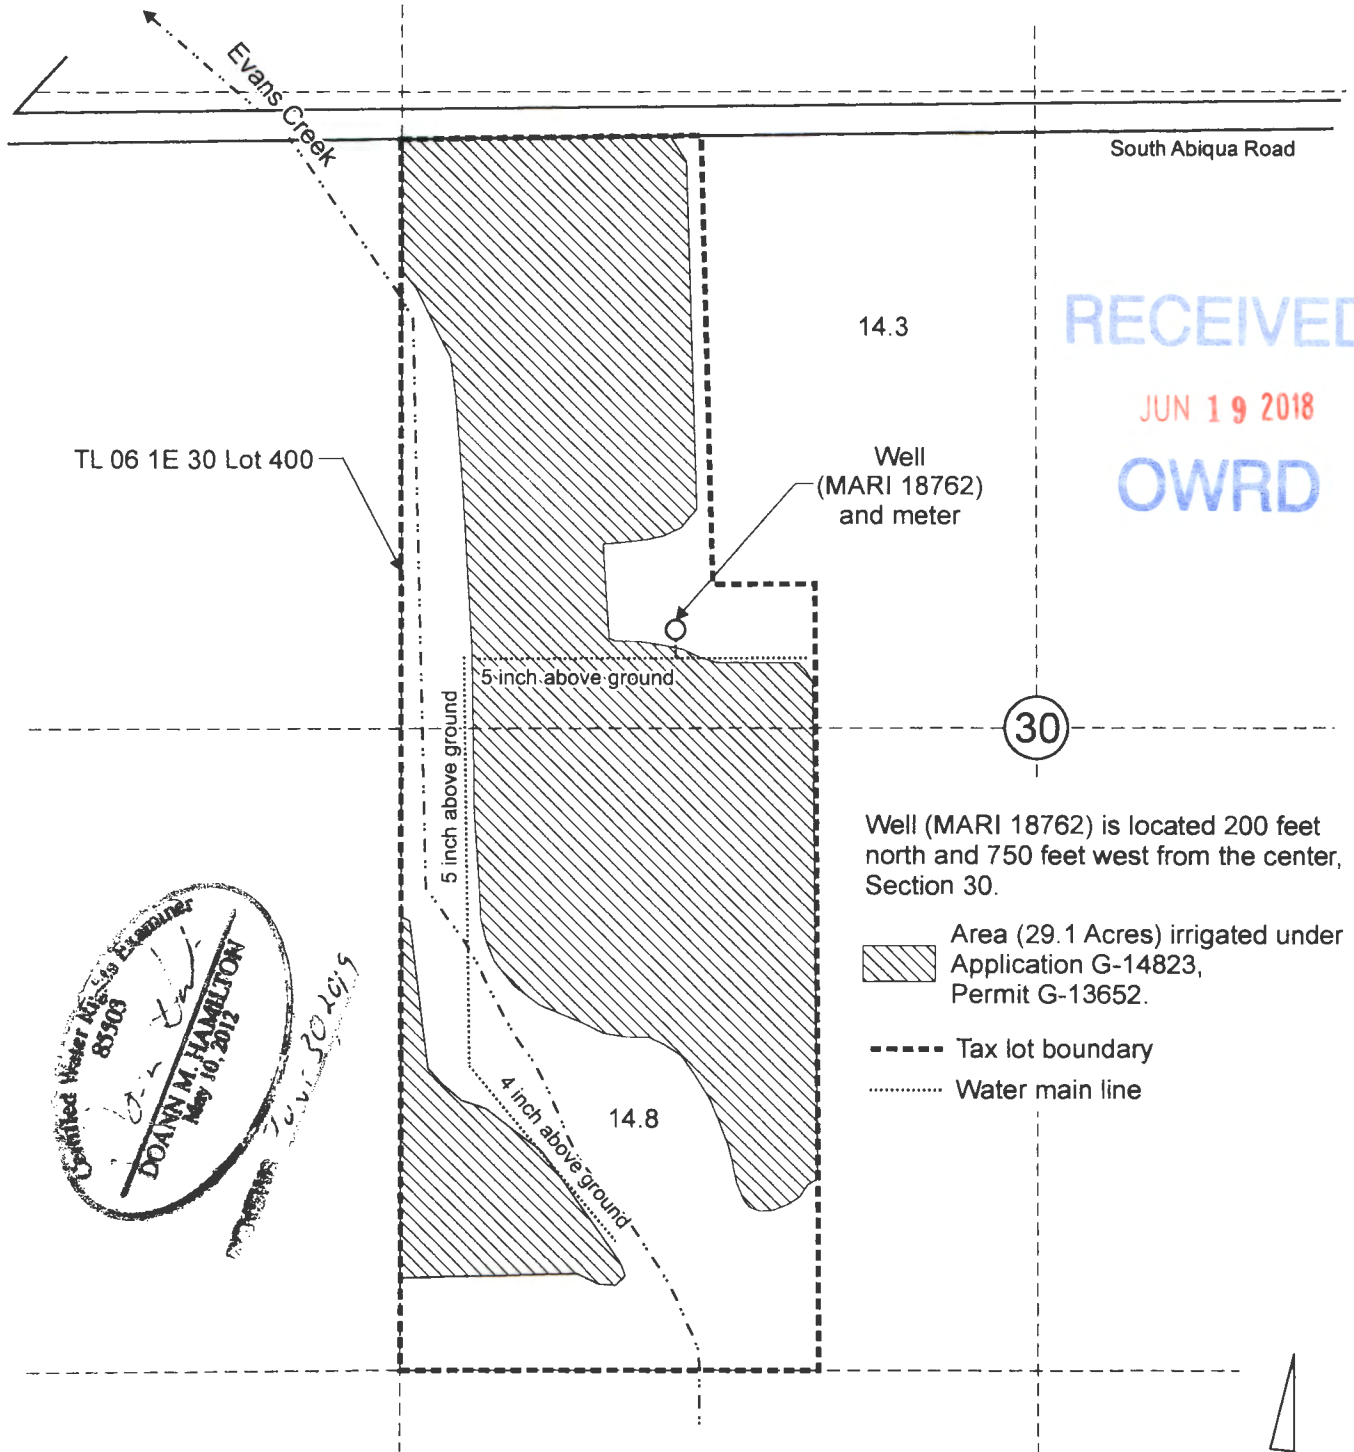

Scale: 1" = 400'

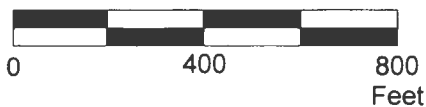

This map was prepared for the purpose of identifying the location of a water right only and is not intended to provide legal dimensions or location of property ownership lines.

Claim of Beneficial Use Map
Application G-14823, Permit G-13652

Valley Loe LLC
T.6S. R.1. Section 30, W.M.

Pacific Hydro-Geology Inc.

06/2018