




Scale
1"=1320'

RECEIVED

MAR 08 2021

OWRD

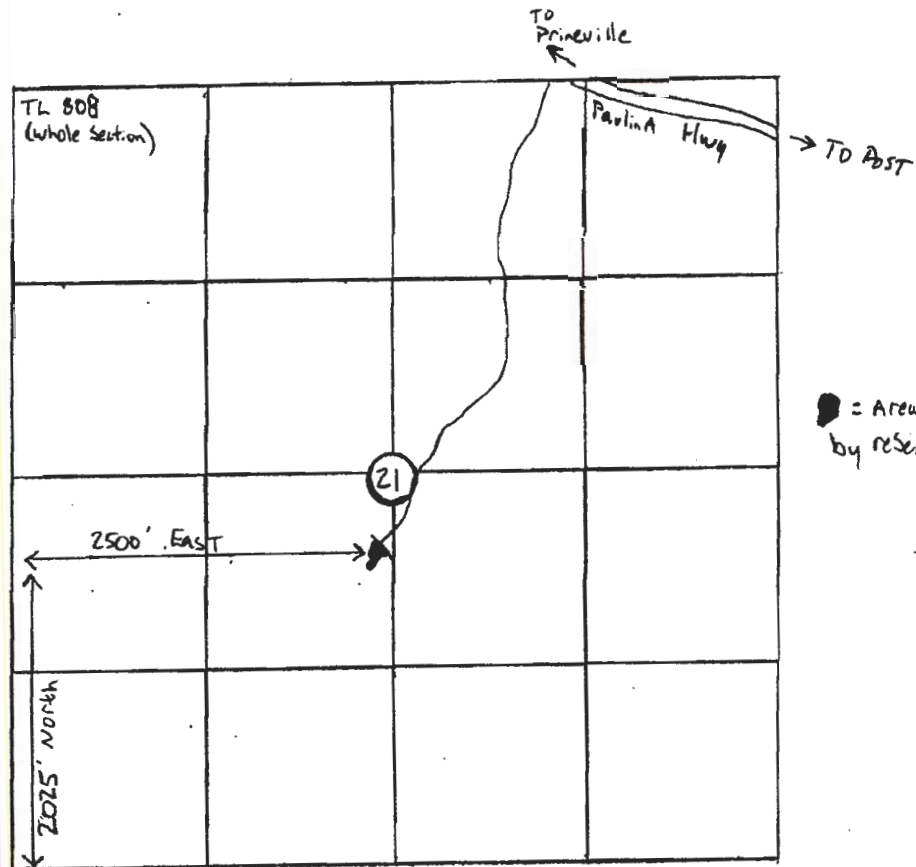

● = Area to be inundated
by reservoir = 80 Acres.

DAM/Reservoir location: NE 1/4 SW 1/4, Township 15 South
Range 17 East, Section 21, W.M.

POD/DAM: 2500' East & 2025' North of the SW Corner of Section 21, T15S R17E, W.M.

FINAL PROOF SURVEY UNDER

Application No. R86910 Permit No.
IN NAME OF

Les Schwab Tire Centers of Oregon, Inc.

Surveyed 19....., by

RECEIVED

JUN 25 2007

WATER RESOURCES DEPT
SALEM, OREGON