




Scale
1" = 1320'

RECEIVED

MAR 08 2021

OWRD

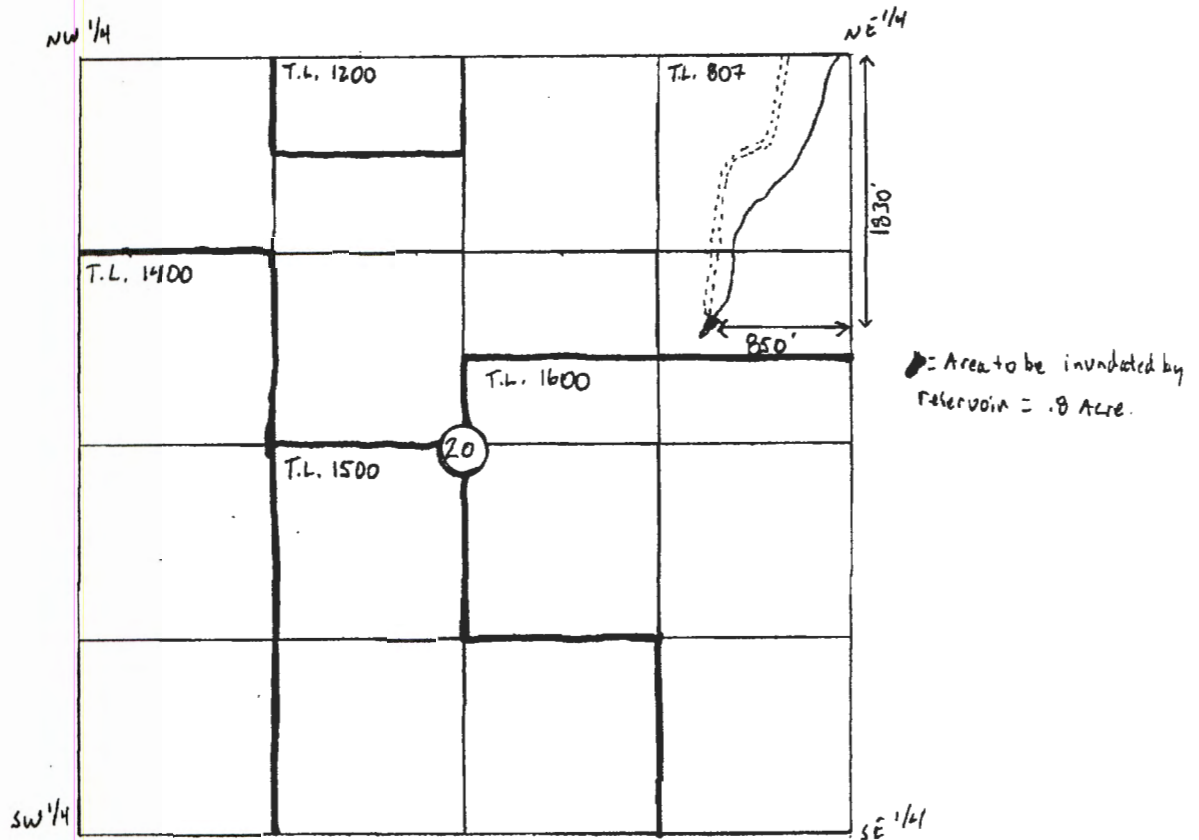

DAM/Reservoir location: SE 1/4 NE 1/4, Township 15 South, Range 17 East, Section 20, W.M.
POB/DAM: 1830' South & 850' West of the NE corner of Section 20, T.15S, R.17E, W.M.

FINAL PROOF SURVEY UNDER

RECEIVED

JUN 25 2007

WATER RESOURCES DEPT
SALEM, OREGON

Application No. R86911 Permit No.
IN NAME OF


Surveyed 19....., by