


CLAIM OF BENEFICIAL USE MAP

TO ADD PLACE OF USE AND A POINT OF APPROPRIATION
FOR APPLICATION G-17275

SW 1/4 OF SECTION 2, TOWNSHIP 24 SOUTH, RANGE 30 EAST, W.M.
TAX LOT: 1400

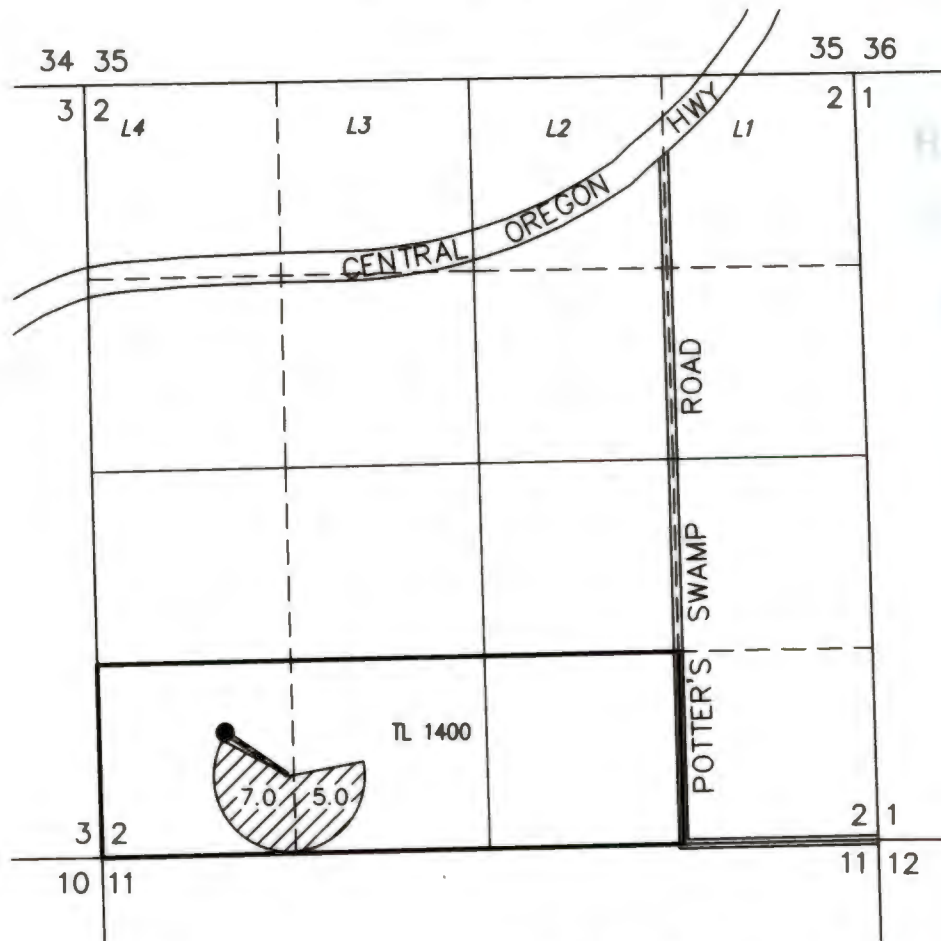

 12.0 AC IR FROM POA
(PERMIT G-16802)

 CONVEYANCE

● POA (HARN 1936)

LOCATED IN THE SW 1/4 SW 1/4 SECTION 2, T24S
R30E, W.M. AND 840 FEET NORTH AND 865 FEET EAST
FROM THE SW CORNER OF SECTION 2. FLOW METER
LOCATED 5 FEET NW OF CENTER PIVOT SPRINKLER.

THIS MAP IS FOR THE PURPOSE OF LOCATING A WATER RIGHT
ONLY AND HAS NO INTENT TO PROVIDE LEGAL DIMENSIONS OR
THE LOCATION OF PROPERTY LINES



RENEWAL DATE: 12/31/2020

PREPARED FOR:

WILLIAM AND LORI PEILA
P.O. BOX 723
HINES, OR 97738

PREPARED BY:



ALL POINTS ENGINEERING AND SURVEYING, INC.
P.O. BOX 767 TERREBONNE, OR 97760
(541) 548-5833 www.APEandS.com