



Claim of Beneficial Use
Application G-17671 Permit G-17455

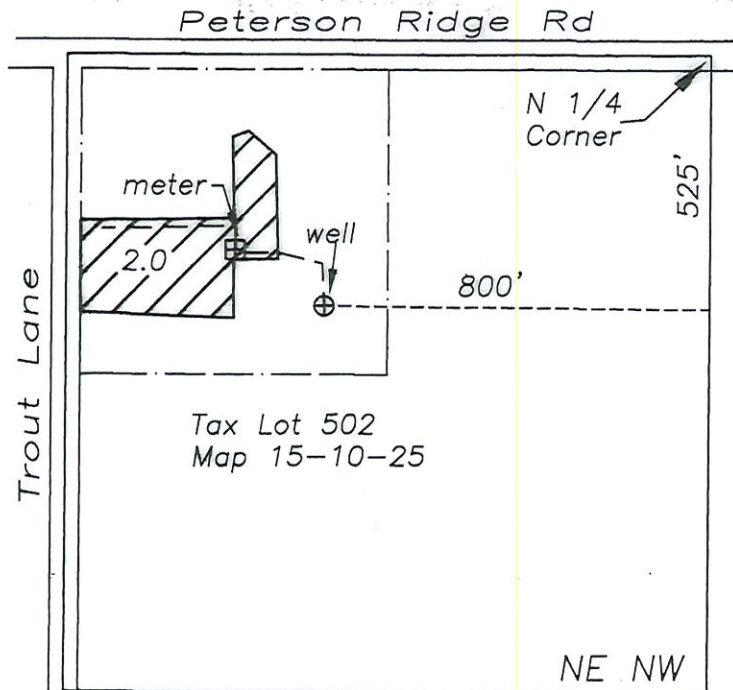

Sec. 25
T15S R10E W.M.
Deschutes Co. OR

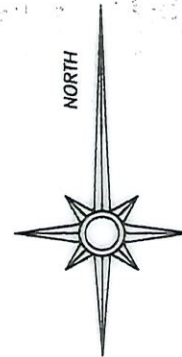

Renewal date: 6/30/2020



Water beneficially used under Permit
G-17455 (priority date 5/13/2013)



Tax lot boundary



Buried mainline



Well




Meter



1/16 Section lines

Point of Appropriation

525' South and 800' West from North 1/4 Corner
Section 25

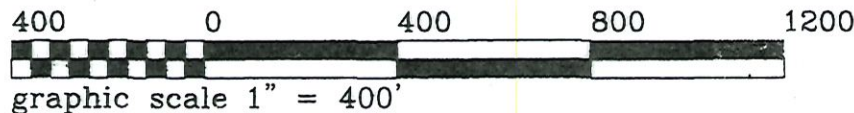

This map is for the purpose of identifying the location of the water right. It is not intended to provide legal dimensions or locations of property ownership lines.