


W1/2 OF SECTION 18, TOWNSHIP 2 N. RANGE 12 E. W.M.  
 WASCO COUNTY, OREGON

**CLAIM OF BENEFICIAL USE MAP**

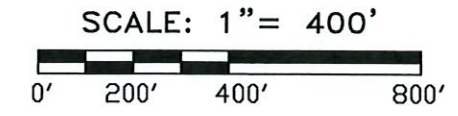

**LEGEND:**

- ADDITIONAL WELL (WASC 51987) 2,000' S. & 760' W.
- EXISTING WELL (WASC 003029) 1410' S. & 1275' W.
- APPLICATION AREA = 8.9 ACRES
- EXISTING IRRIGATION MAIN
- CREEK WITH DRAINAGE FLOW
- EXISTING PONDS

RECEIVED  
 DEC 23 2019  
 OWRD

TRANSFER No. 11443


IN THE NAME OF:

THE CHERRY RANCH, LLC

DATE: OCTOBER 10, 2019

BY: **TENNESON ENGINEERING CORP.**

3775 CRATES WAY  
 THE DALLES, OREGON. 97058  
 PH. 541-296-9177  
 FAX 541-296-6657

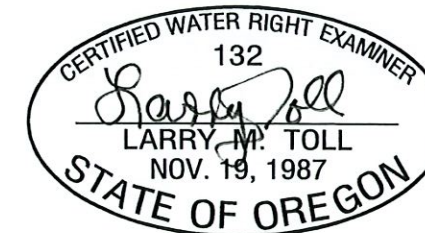

EXPIRES: 06/30/2020

**NOTE:**

"THIS MAP IS NOT INTENDED TO PROVIDE LEGAL DIMENSIONS OR LOCATIONS OF PROPERTY OWNERSHIP LINES."

