

**Map of
Claim of Beneficial Use
Application R-86357
Permit R-14856
T 38 S, R 18 E, Sec. 32**


Legend

- Survey monument found
- Creek
- ⬜ Natural lake foot print
- ▭ Lake foot print at elev. of spillway

Note: This map is not intended to provide legal dimensions or locations of property ownership lines.



1 inch = 1,320 feet

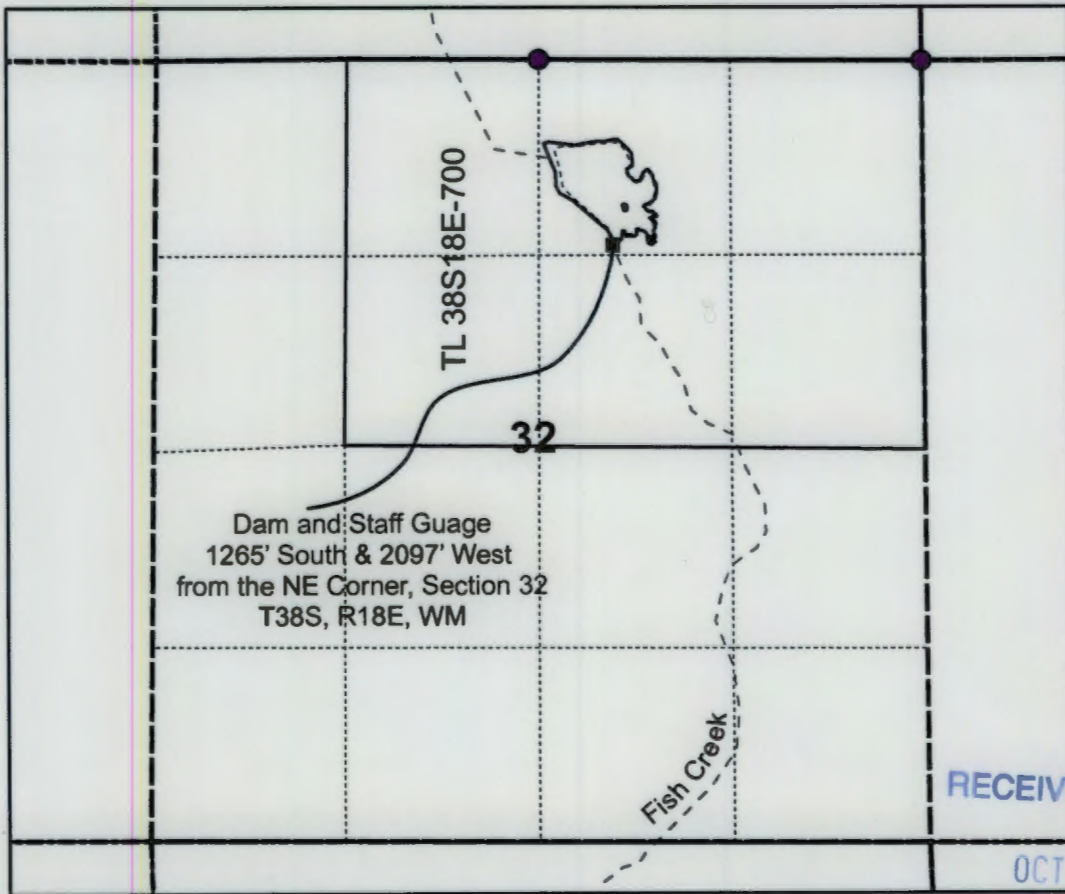

RECEIVED BY OWRD

OCT 03 2016

SALEM, OR